
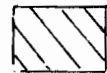


RECEIVED

APR 1 6 1985

WATER RESOURCES DEPT.
SALEM, OREGON

T.5S., R.1E., W. M.

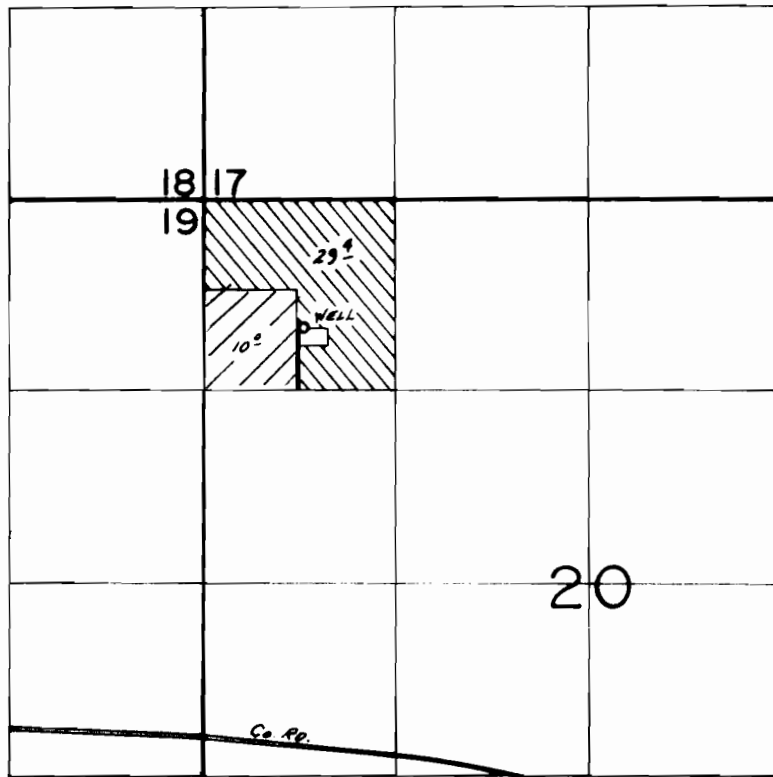

- Permit
G-6155



- New
Application

WELL LOC: 880'S. & 690'E. FROM NW COR. SEC. 20

SCALE: 1"=1320'

FINAL PROOF SURVEY
UNDER

Application No. G-6551. Permit No. G-6155.....
IN NAME OF

.....ZOTIK KOSHKAROFF.....

Surveyed Aug. 8, 1984, by J.R. WOODROOF.

Application No. G-11375
Permit No. G10437

DFR 244-24

10/18