




T. 15S., R. 40E., W.M.

17

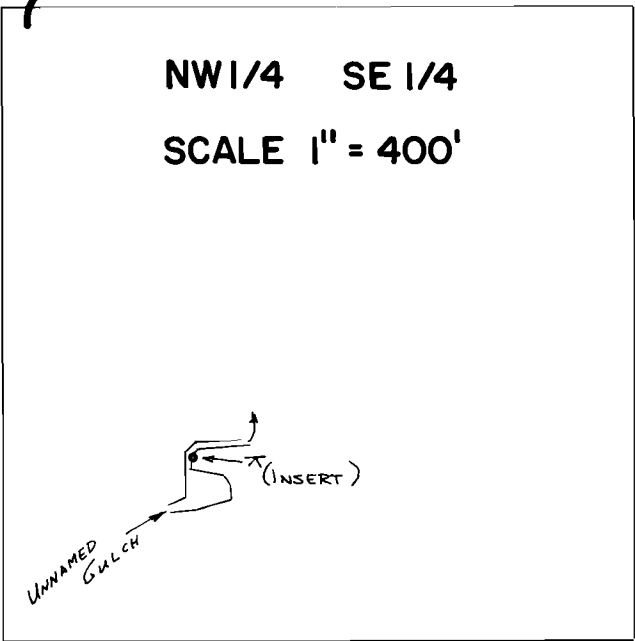

Div. Pt. Loc: 960'S. & 390'E. FROM CENTER COR. SEC. 17

SCALE 1" = 1320'

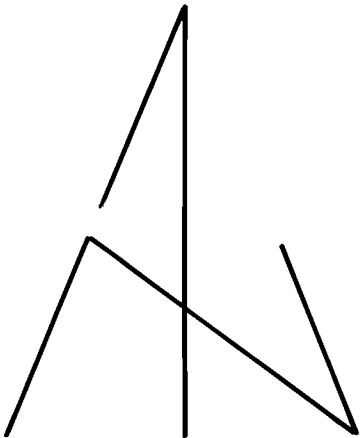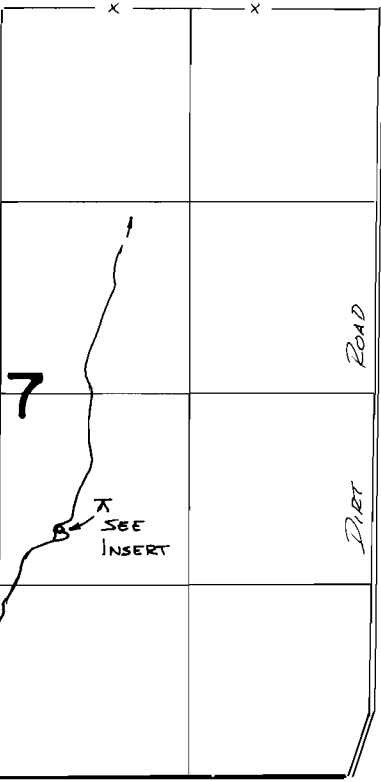

FINAL PROOF SURVEY
UNDER

Application No. **R:37351** Permit No. **R:6717**.....
IN NAME OF
DAVIS LAND & LIVESTOCK CO.
.....
Surveyed 4-21 1988, by V.L. Church.....

PTS / 41045-278-93R

253.
12-29-88 V.L.C.