


T.26S.R.9E.W.M.

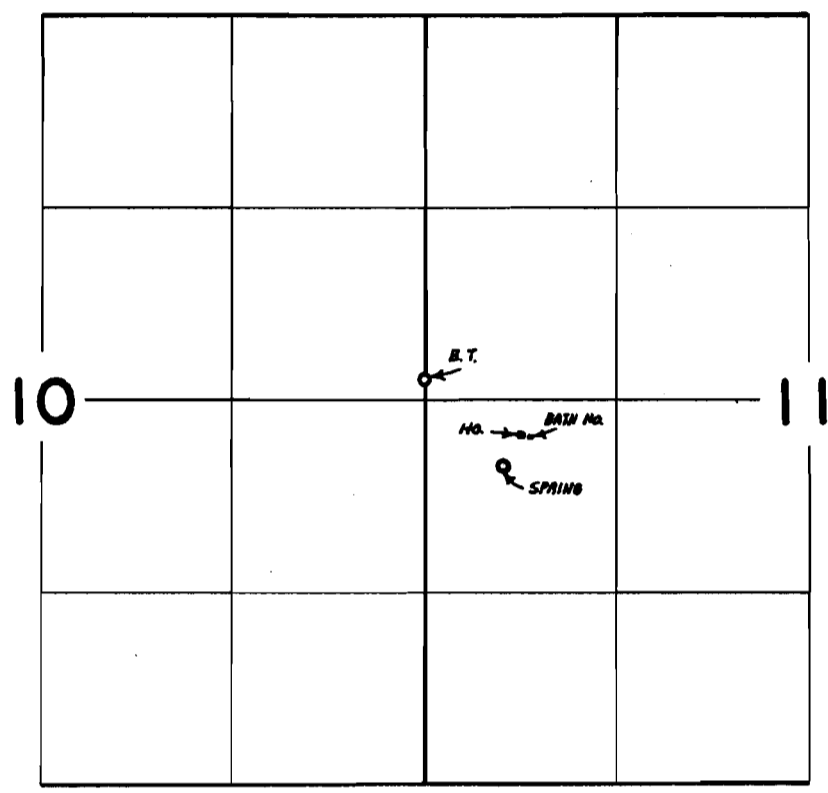

SPRING LOC. 460'S. & 535'E. FROM W 1/4 COR. SEC. 11

FINAL PROOF SURVEY

UNDER

Application No. 45619 Permit No. 34073

IN NAME OF

LOWE, INC.

Surveyed OCT. 30 19 70, by G. BACA