


T.2S. R.5E. WM.

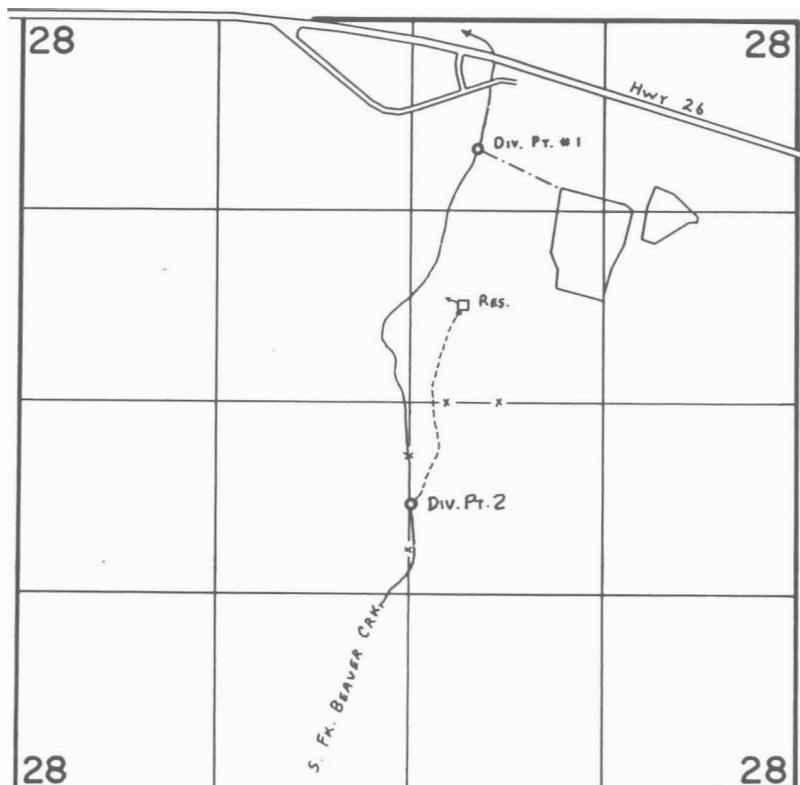

DIV. PTS. LOC:

#1- 1750' N. & 460' E.

#2- 700' S. & 10' E.

RES: 650' N & 350' E } ALL FROM C. 1/4 COR. SEC. 28.

FINAL PROOF SURVEY UNDER

Transfer No. T-2678

R-49479

R-5962

Application No. 4948Q. Permit No. 36754.....

IN NAME OF

.....ORLEEN PRESTON.....

Surveyed July 13, 1978, by C. L. HUGHES.....
April 25 1979