


T.2S. R.5E. W.M.

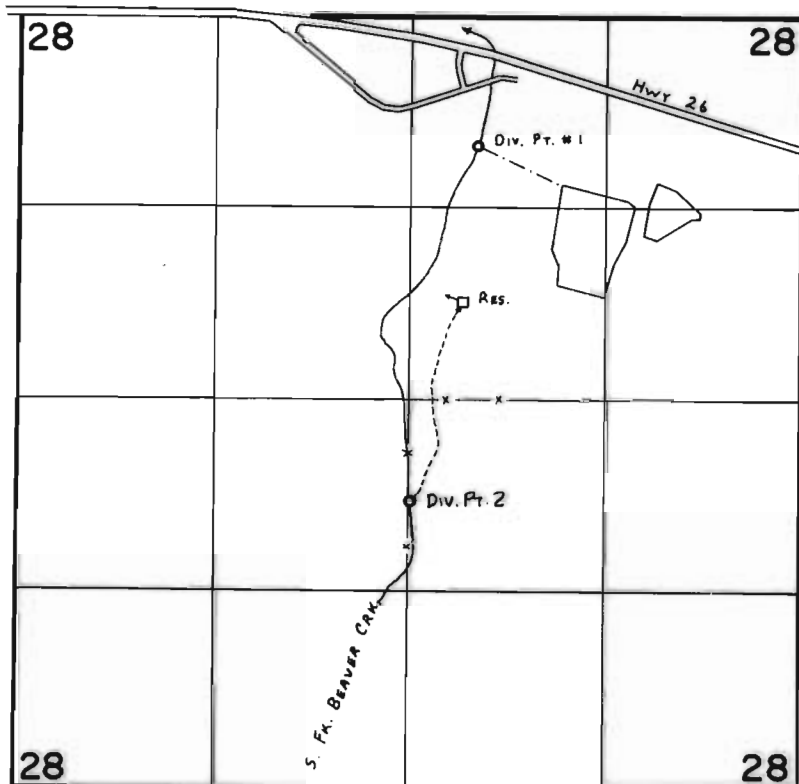

DIV. PTS. LOC:

#1- 175' N. & 460' E. } ALL FROM C. 1/4 COR. SEC. 28.
#2- 700' S. & 10' E. }
RES- 650' N. & 350' E. }

FINAL PROOF SURVEY UNDER

Transfer No. T-2678

R-49479

R-5962

Application No. 49480 Permit No. 36754

IN NAME OF

ORLEEN PRESTON

Surveyed July 13, 1978, by C. L. HUGHES
April 25, 1979