


T.36S., R.2E., W. M.

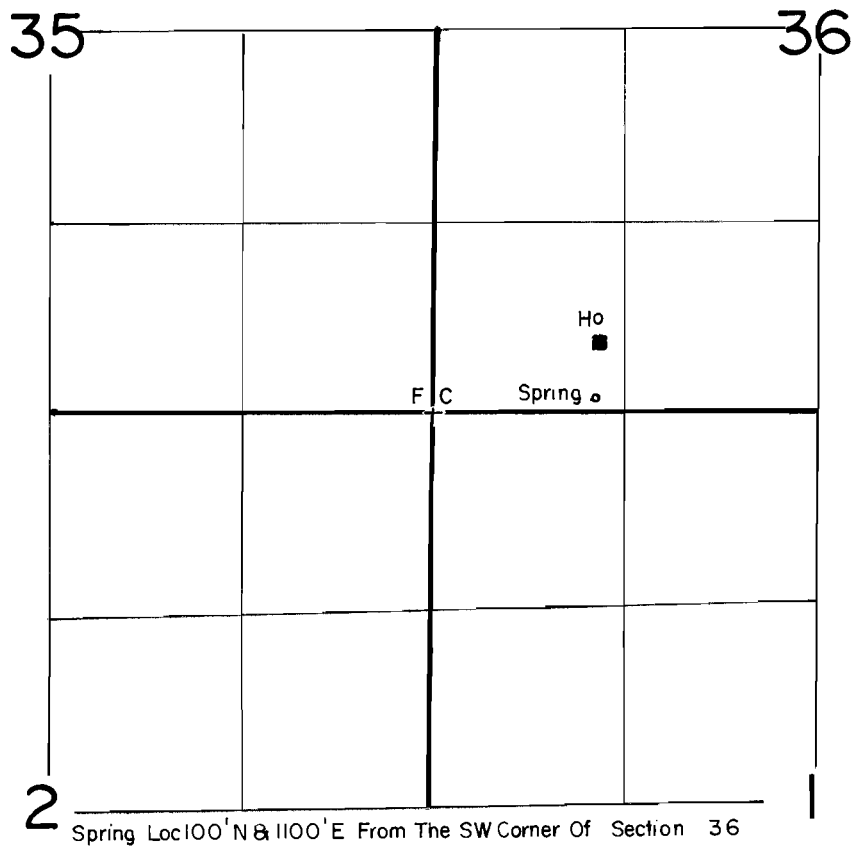

SCALE: 1" = 1320'

FINAL PROOF SURVEY
UNDER

Application No. 50365.. Permit No. 38018.....
IN NAME OF

....GLENNE W. & EVA L. ALBERT.....

Surveyed JULY 11... 1989., by B.S. JAMES.....