





T.1N. & IS., R.43E., W.M.

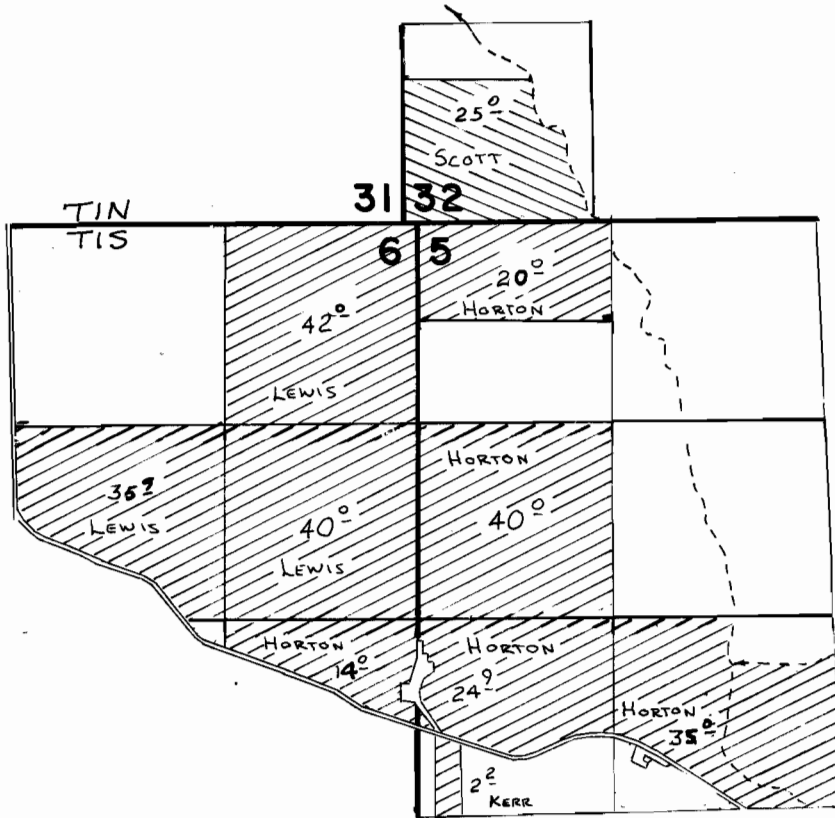

-  PRIMARY
-  SUPPLEMENTAL



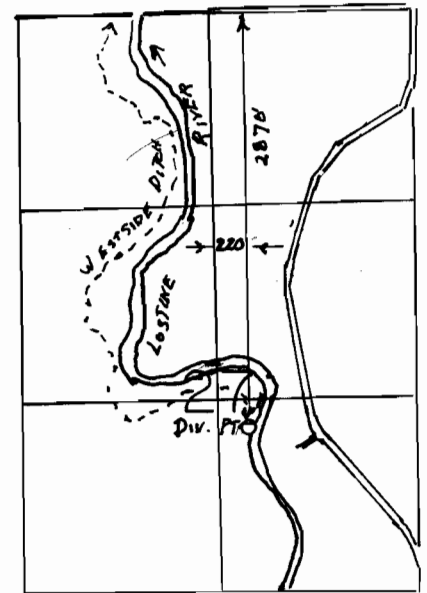FINAL PROOF SURVEY UNDER

Application No. **50421** Permit No. **38052**
IN NAME OF

ALLEN CANYON SPRINKLER ASSOC.

Surveyed 8-12 1982, by V.L. Church