


T.5S.,R.4&5W.,W.M.

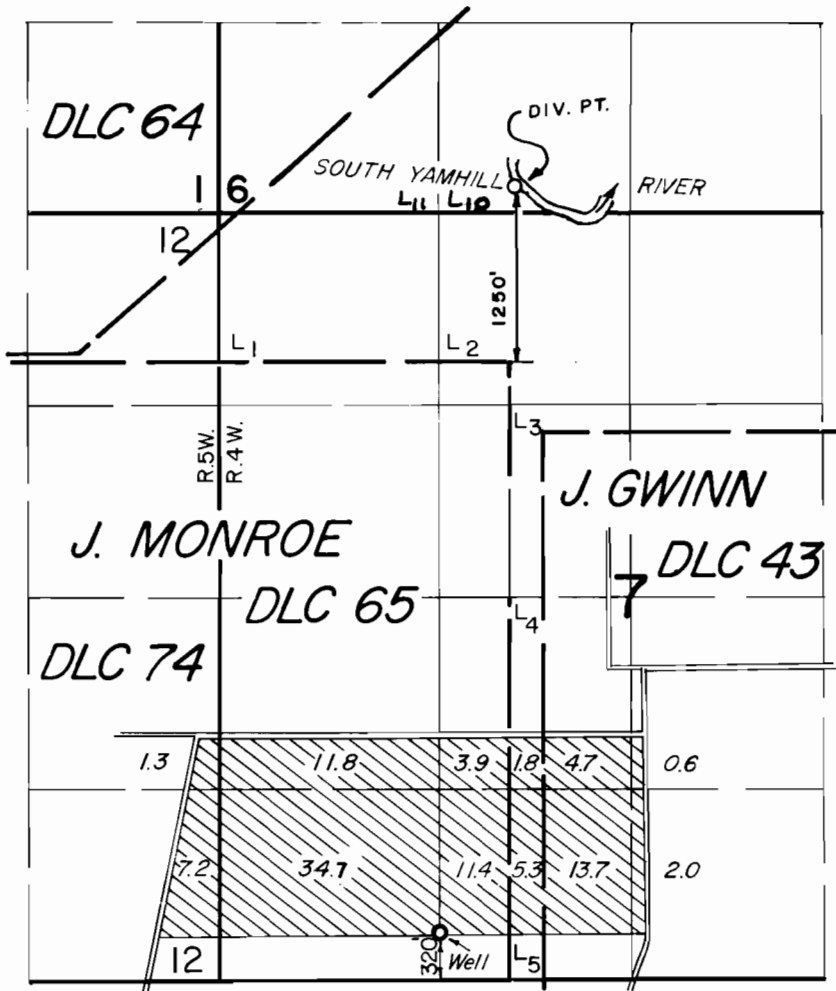

FINAL PROOF SURVEY UNDER

Application No. 51039 G-6585 Permit No. 38520 G-5828...

IN NAME OF

SHARER

Surveyed MAY 31, 1979, by *Alban*