


T.32S.,R.15W.,W.M.

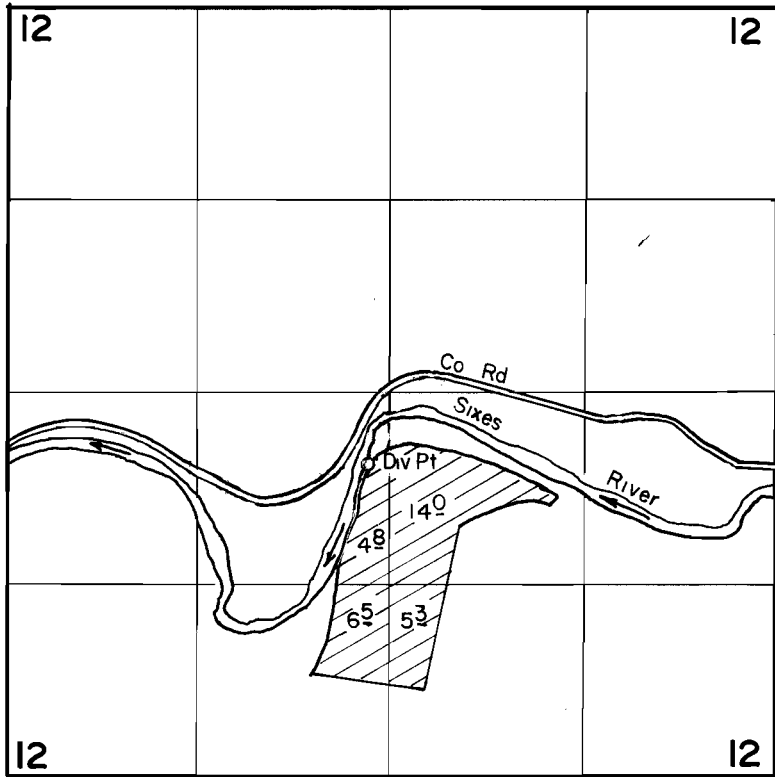

Div Pt Located 2150' N. & 150' W. From The S 1/4 Corner Of Section 12

SCALE:1"=1320'

**FINAL PROOF SURVEY**  
UNDER

Application No. 51055..... Permit No. 37816.....  
IN NAME OF

.....**RICHARD L & BETHINA J GOERGAN**.....

Surveyed JUNE 26... 19.89, by B S JAMES.....