



T.2N., R.3W., W. M.

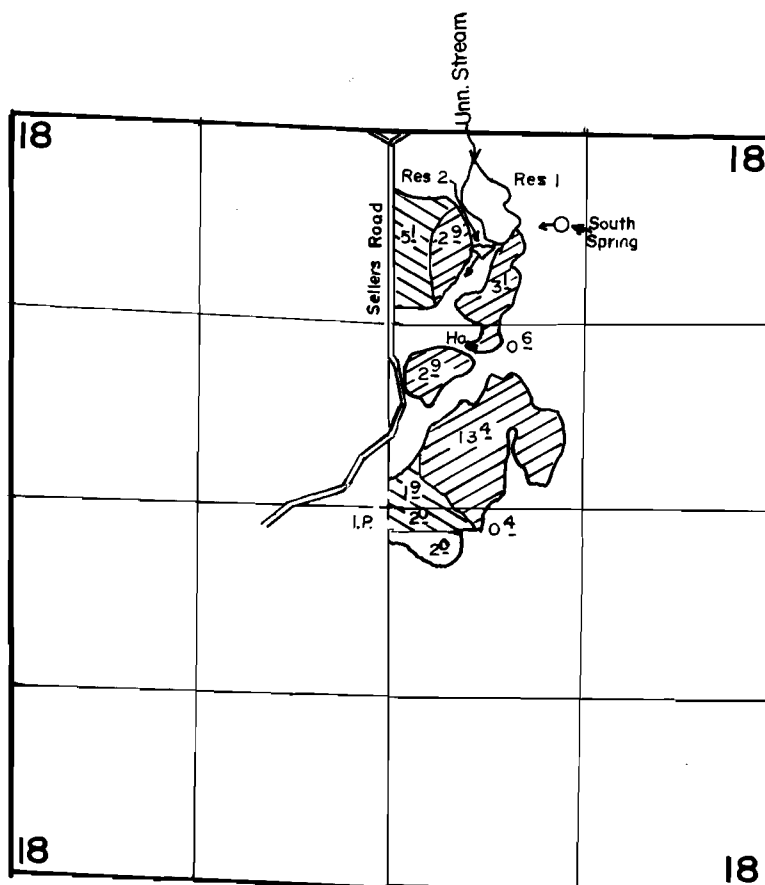

Div. Pts Loc: Res 1, 700' S & 730' E, Res 2, 850' S & 600' E, South Spr.
620' S & 1170' E, All From N1/4 Corner Of Section 18

SCALE: 1"=1320'

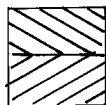

PRIMARY

SUPPLEMENTAL

FINAL PROOF SURVEY UNDER

R-51094

R-6482

Application No. 51095..... Permit No. 40679.....

IN NAME OF

.....LARRY J. SELLERS.....

Surveyed JUNE 30... 1989, by R.G. MUCKEN.....