


T.34S., R.6W., W.M.

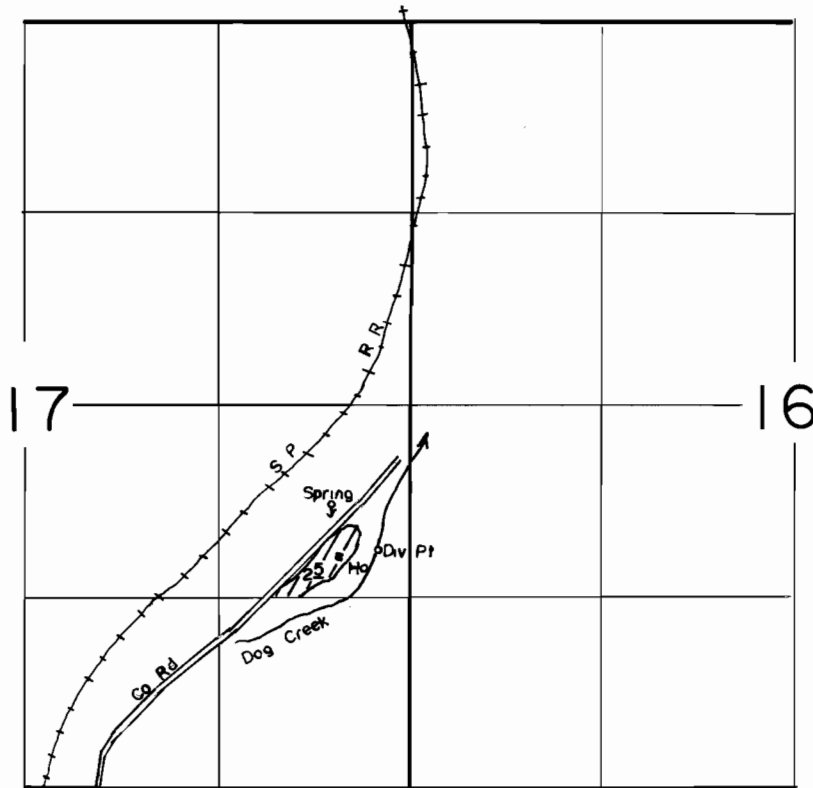

Spring Loc 650' N & 550' W, Div Pt Loc 330' N & 220' W Both From The  
NE Corner Of SE 1/4 SE 1/4 Section 17

SCALE: 1" = 1320'

**FINAL PROOF SURVEY**  
UNDER

Application No. 51363..... Permit No. 38844.....  
IN NAME OF

.....CLIFFORD.....HENROTIN.....

Surveyed MAY 17 1989, by B.S. JAMES.....