


T. 2S., R. 44E., W. M.



SCALE 1" = 1320'

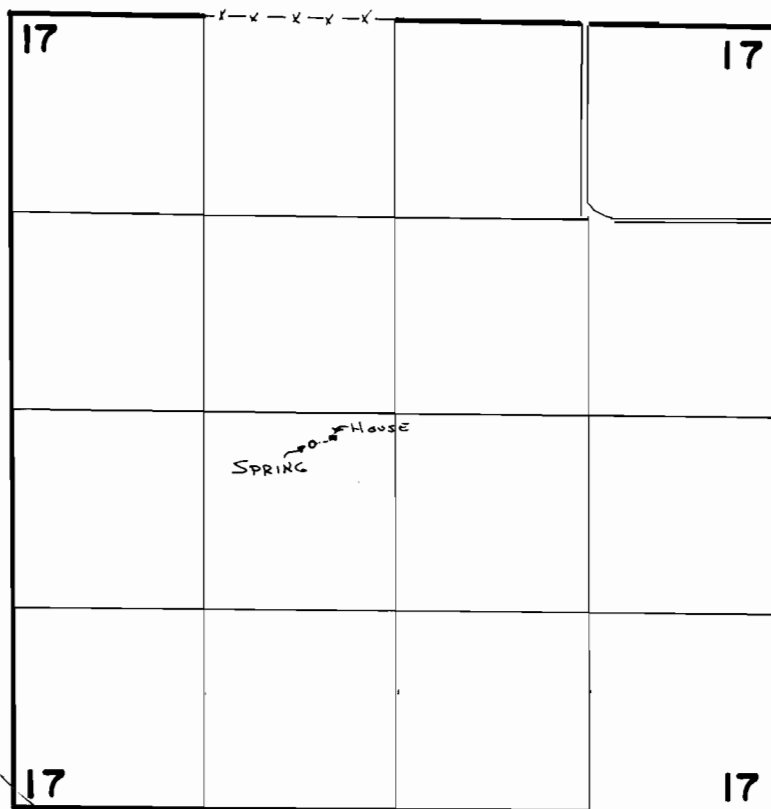

SPRING LOC: 210'S & 570'W. FROM CENTER SEC 17

FINAL PROOF SURVEY

UNDER

Application No. **51834** Permit No. **37818**
IN NAME OF

DALE E. & PATRICIA C. GREENLEE

Surveyed **8-10** 19**88**, by **V.L. Church**