


# T.2N., R.40E., W.M.

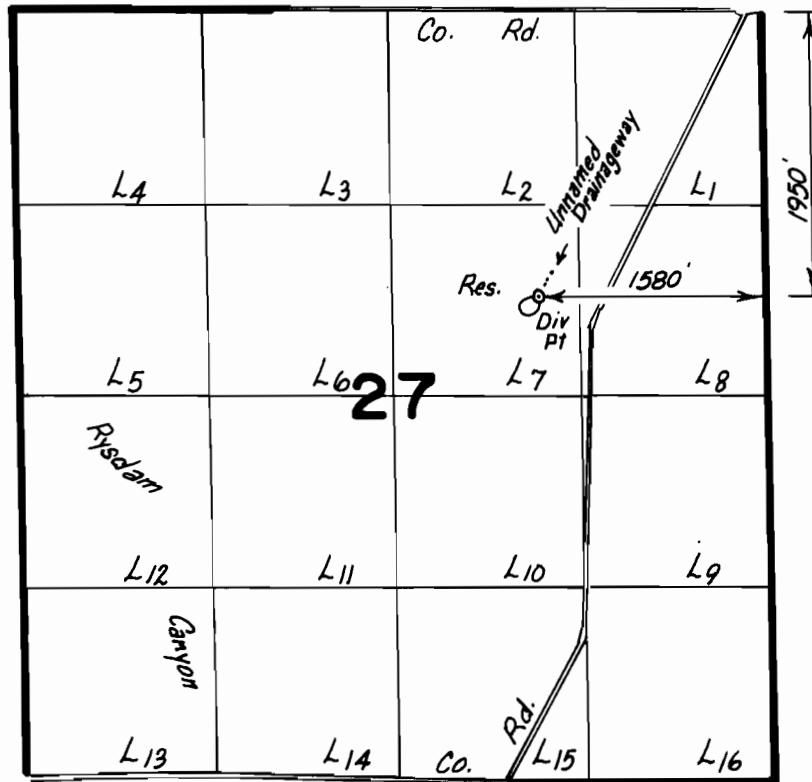

Scale: 1" = 1320'

## FINAL PROOF SURVEY UNDER

Application No. **R51979** Permit No. **R6257**  
IN NAME OF

**WILLIS & THELMA PRATT**

Surveyed **10-29-1987**, by **Vern Church**