


T. 35 S., R. 3 W., W. M.

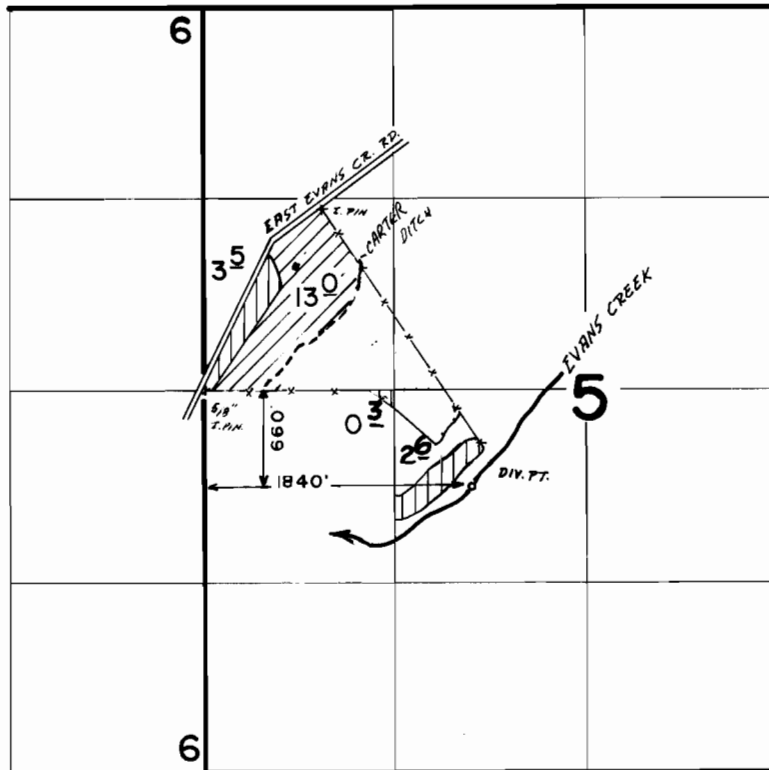

N
SCALE
1" = 1320'

- PRIMARY
- SUPPLEMENTAL

FINAL PROOF SURVEY
UNDER

Application No. 52336.. Permit No. 42550.....
IN NAME OF

EARL E. & or MERRY J. SAMSON

Surveyed Nov. 13., 1984, by J.R. WOODROOF

by