


39654


65186

T. 40S. R. 4E. W. M.

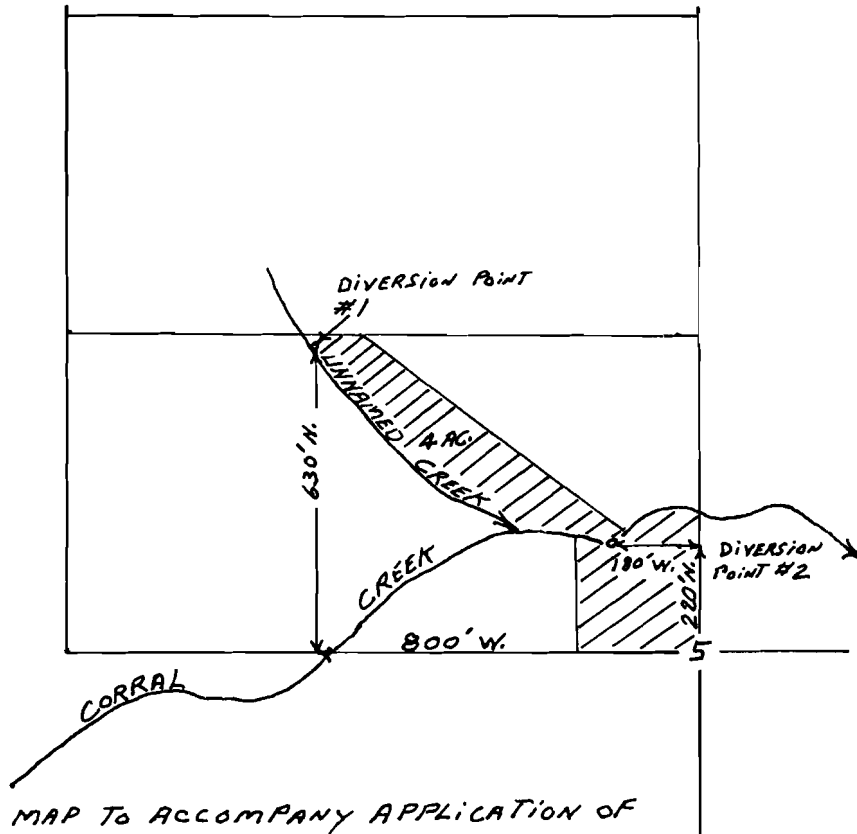

MAP TO ACCOMPANY APPLICATION OF
THOMAS E. STARK FOR IRRIGATION

SCALE 1" = 400'

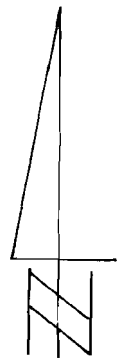

11-4-74

52563

39654

Boomer Creek N.W.