


T. 32S., R. 14W., W.M.

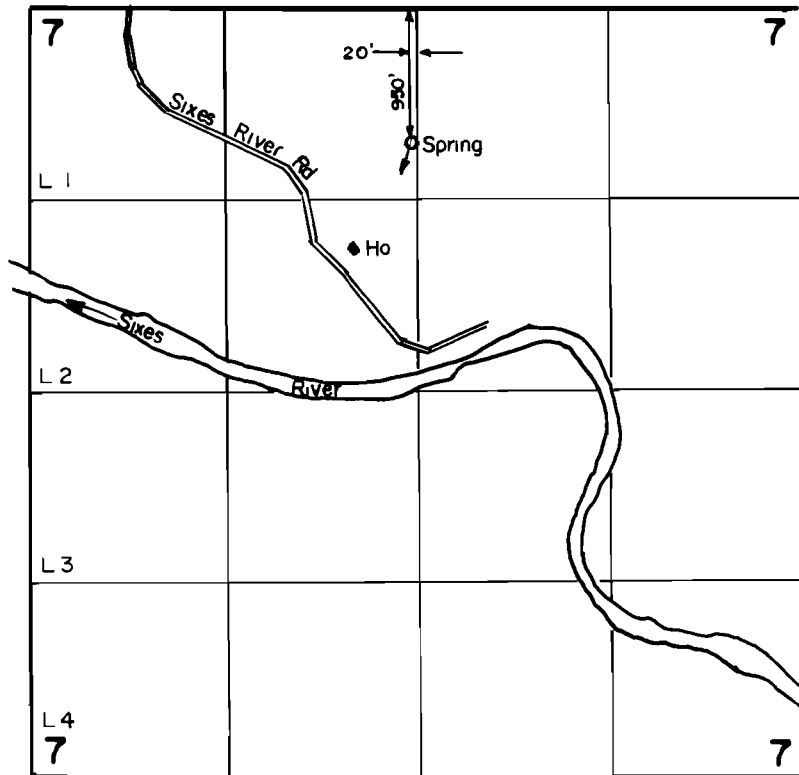

SCALE: 1" = 1320'

FINAL PROOF SURVEY
UNDER

Application No. 52597... Permit No. 37826.....

IN NAME OF

.....**FRED H. NOTT**.....

Surveyed JULY 31, 1989, by B.S. JAMES.....