


P-38814
LS188



T.8 & 9 S. R.27 E. W.M.

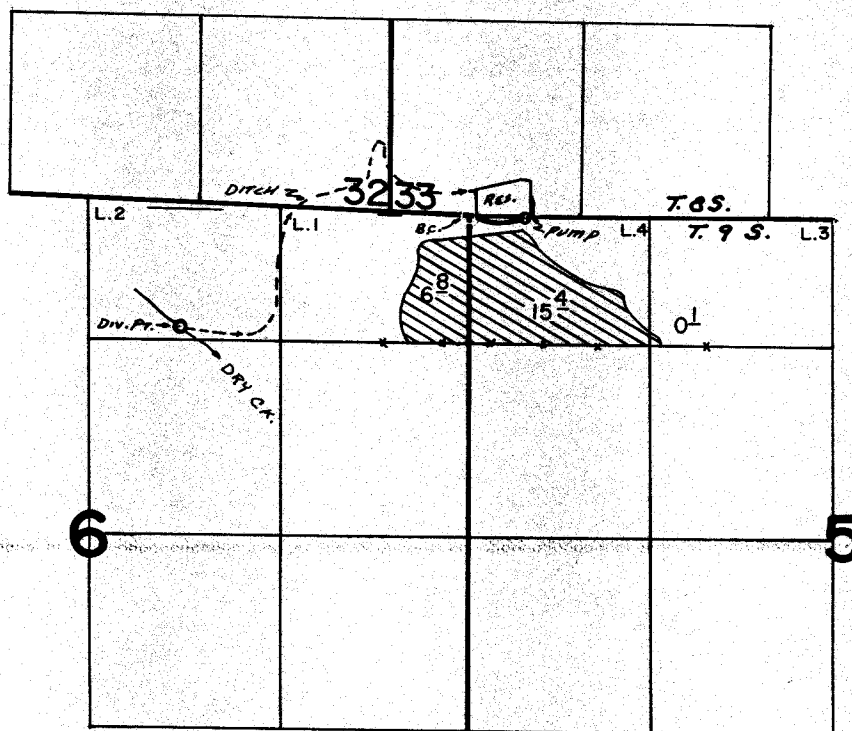

CREEK DIV. PT. - 820.5' ± 1450' N ± Both From SW Cor. Sec. 33
RES. DIV. PT. - 170' N ± 600' E

**FINAL PROOF SURVEY
UNDER**

R-52048

R-6222

Application No. 53180 Permit No. 38814
IN NAME OF

TOM J. & M. DARLENE DOHERTY

Surveyed Oct. 13, 1977, by S.C. BROWN
Surveyed June 16, 1988, by Z.F. SALEH

3-19-90
41023-179-60R

PTS-1977-L 60R