
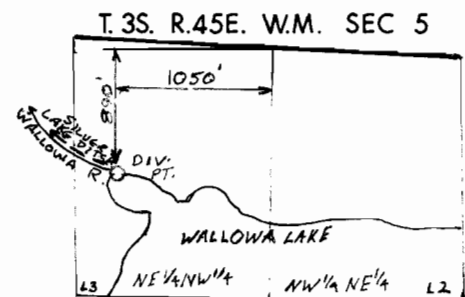


T. 2S. R.45E. W. M.

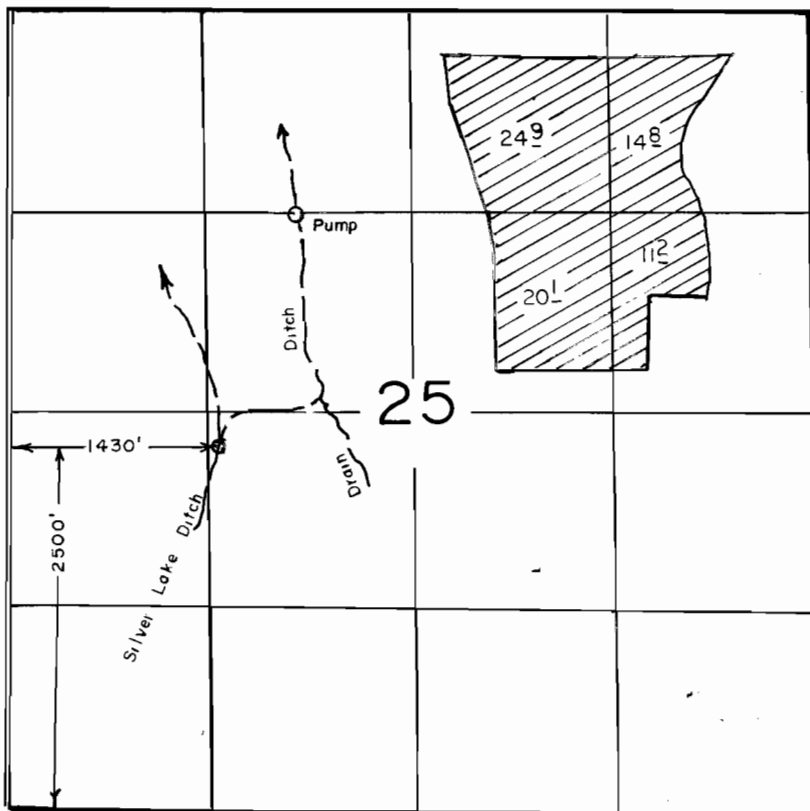

SCALE: 1"=1320'

FINAL PROOF SURVEY UNDER

Application No. 54081... Permit No. 40712.....
IN NAME OF

GARDNER L. LOCKE

Surveyed AUG. 18. 1978., by R. BARWIN