


T. 3 S., R. 2 E., W. M.

Sec. 26

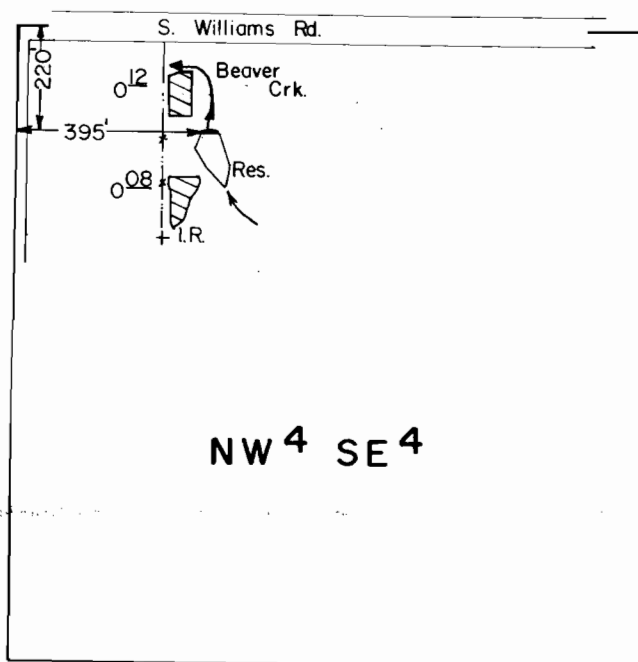

Scale: 1" = 400'

FINAL PROOF SURVEY
UNDER

R-54187 R-6486
Application No. 54475 Permit No. 40683
IN NAME OF

RUDOLF & H. K. GRIESSMAN

Surveyed AUG. 1, 1986, by T. Warren

PTS-1986-C
TMW 2/9/87