


T.32S, R.14 W., W.M.

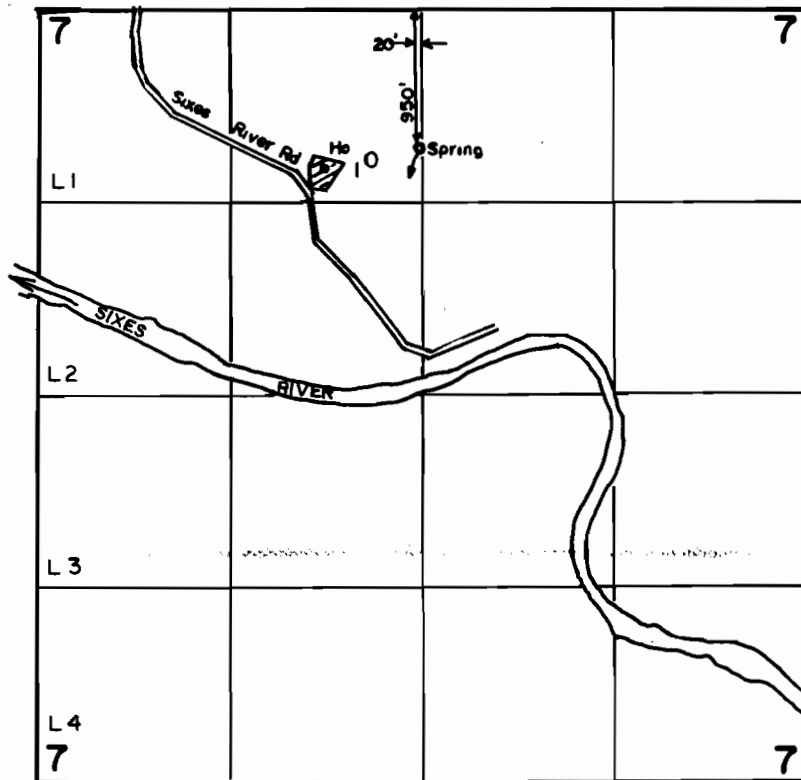

SCALE: 1"=1320'

FINAL PROOF SURVEY
UNDER

Application No. 54813..... Permit No. 41122.....
IN NAME OF

.....**MARTIN J. ROTH**.....

Surveyed JULY...31.. 1989., by B.S. JAMES.....