


# T. 28 S., R. 12 W., W. M.

## SECTION 15

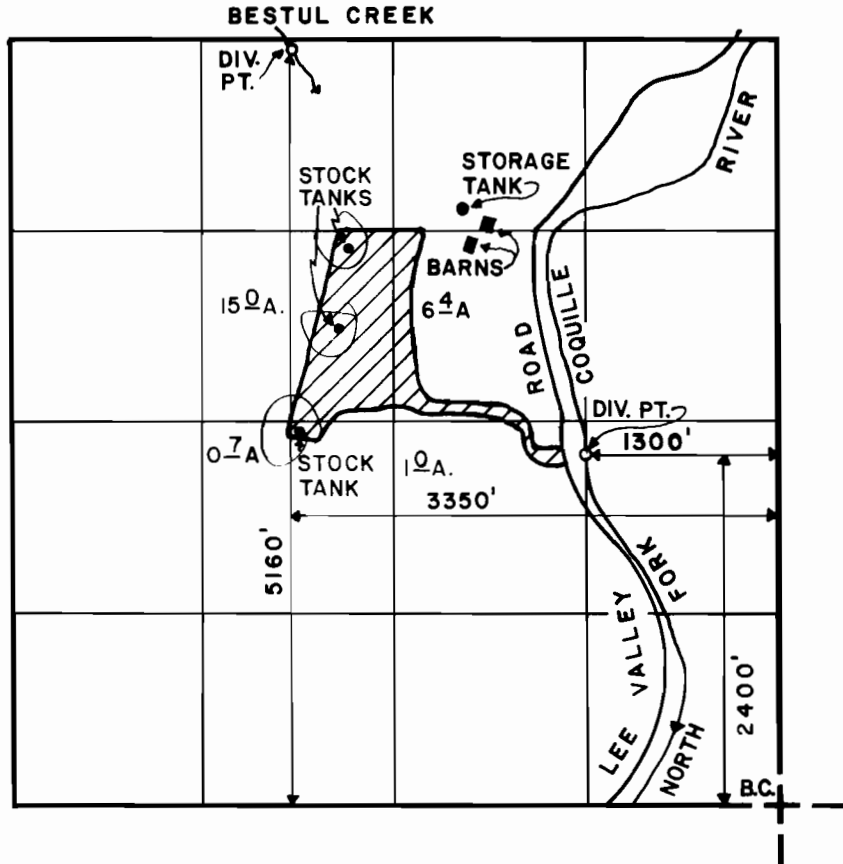

SCALE: 4" = 1 MILE

### FINAL PROOF SURVEY UNDER

Application No. 56479      Permit No. 42455  
54889      41166  
IN NAME OF

ROSS, ROBERT

Surveyed AUG. 27 1985, by J.M. SCHMORDE