


# T. 36 S., R. 7 E., W. M.

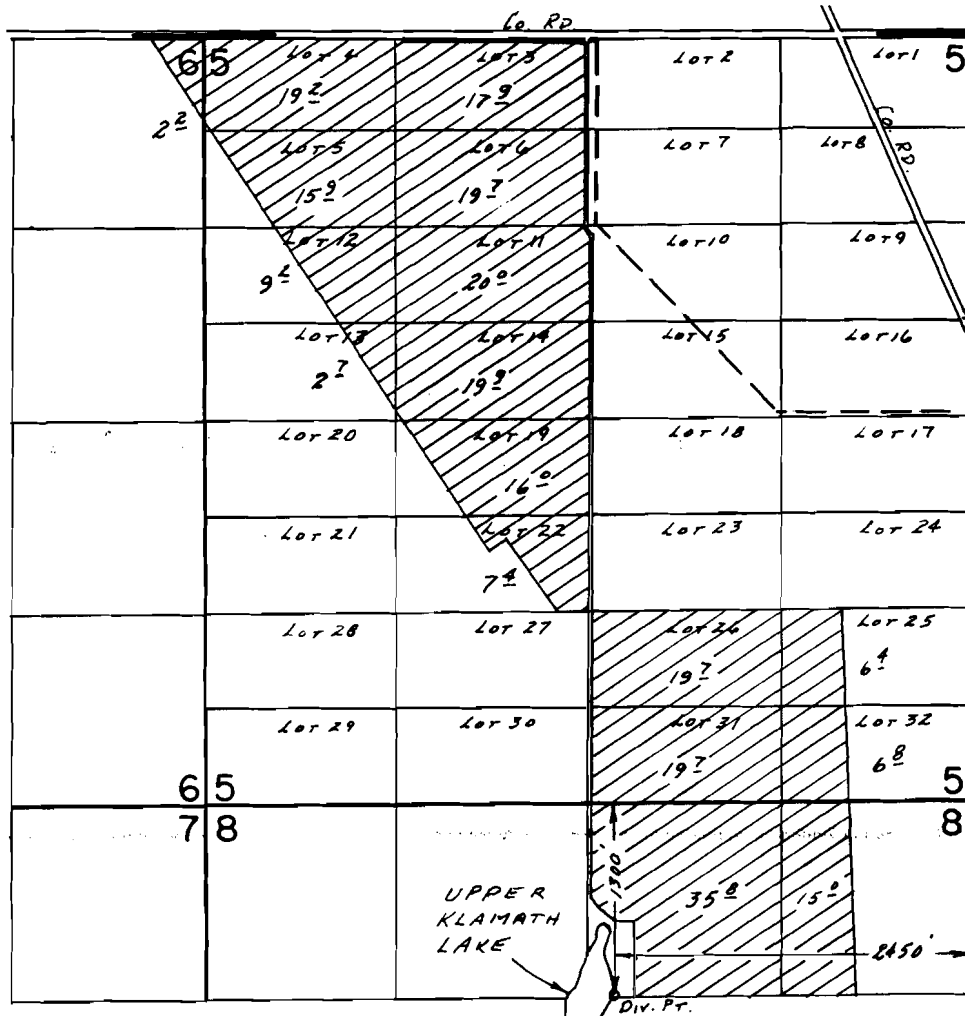

SCALE: 1" = 1320'

## FINAL PROOF SURVEY UNDER

Application No. 55542.. Permit No. 41856.....  
IN NAME OF

.....  
Surveyed May 26... 1988, by B.W. BISHOP.....