


T.13S., R. 29E., W.M.

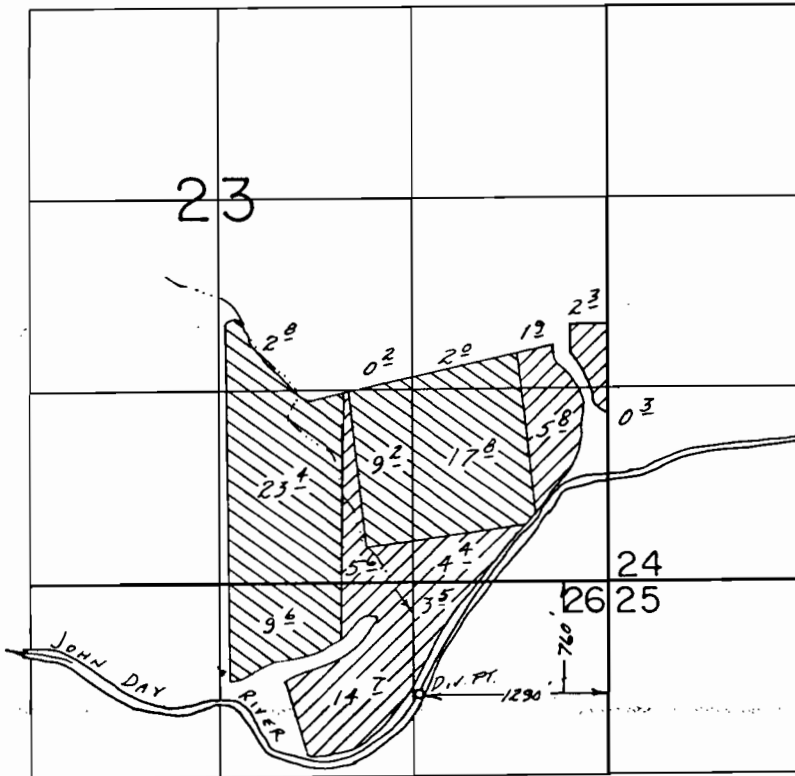

SCALE: 1" = 1320'

FINAL PROOF SURVEY
UNDER

55580

41655

Application No. 62956... Permit No. 47357.....



IN NAME OF

HOMER L. & JEANETTE E. HARRISON

Surveyed June 20, 1988, by V.L. CHURCH.....

4/13/89 JWB
41023-179-235R