


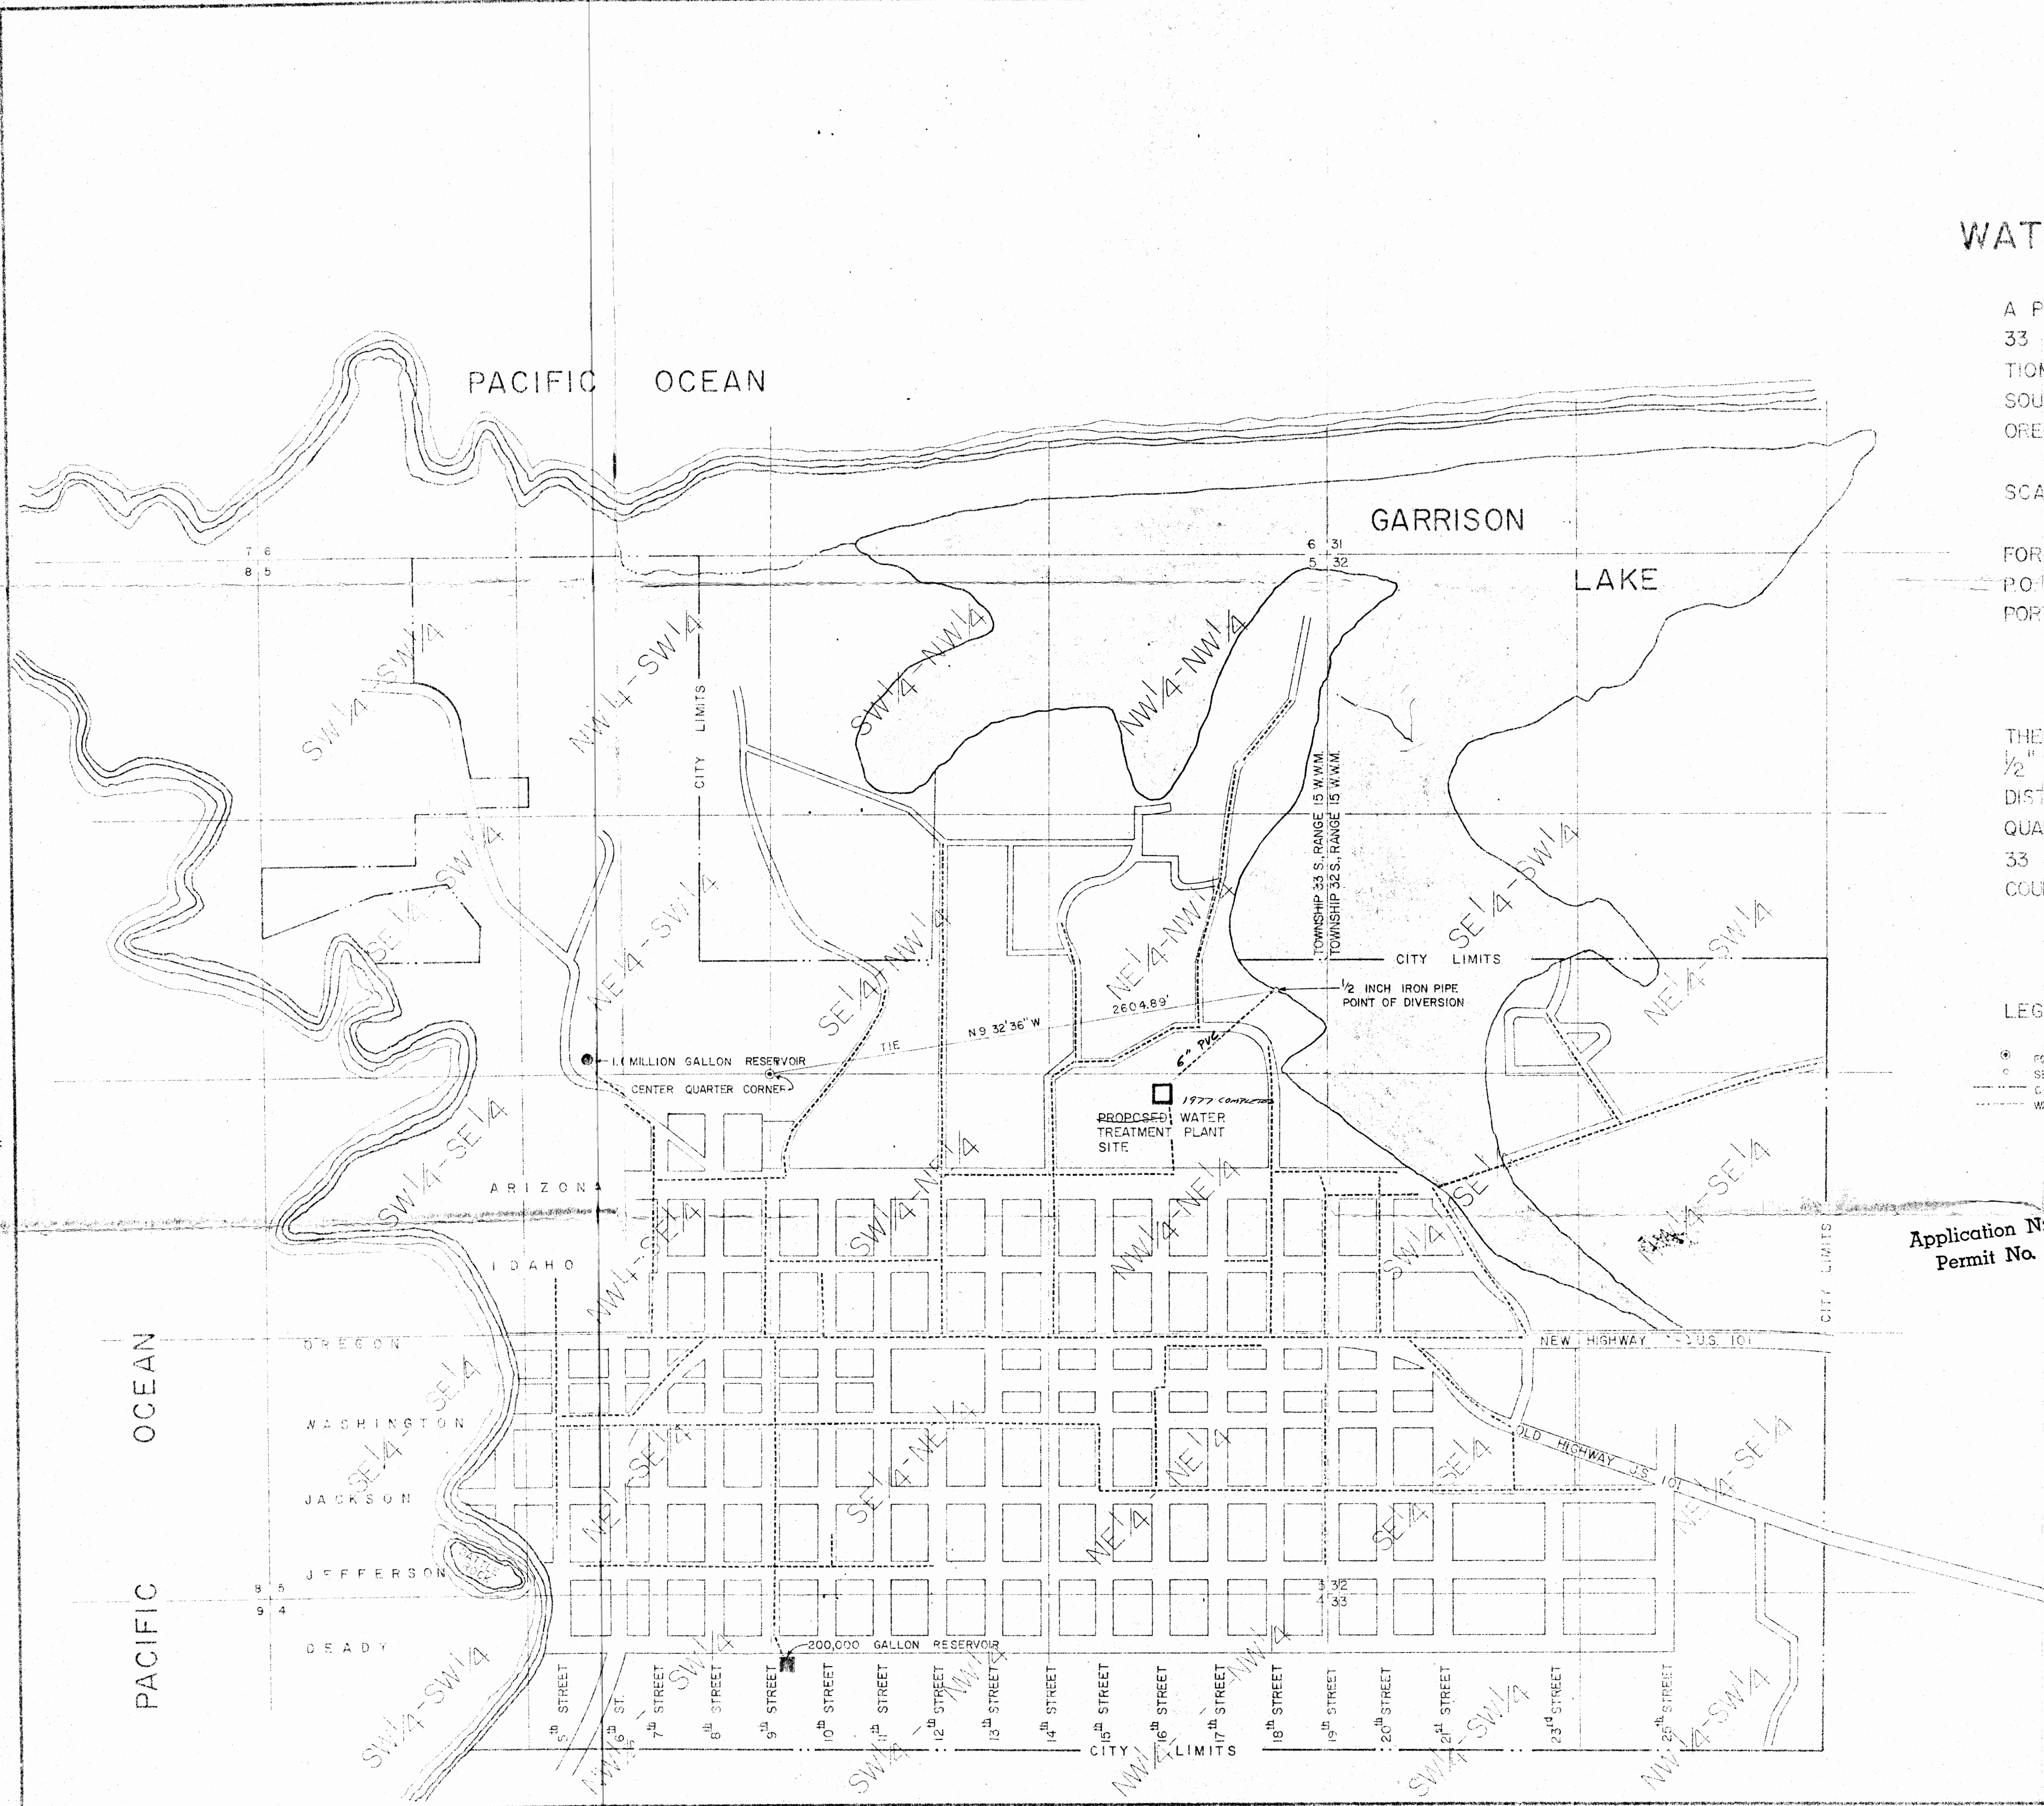

WATER RIGHTS SURVEY

A PORTION OF SECTIONS 4 AND 5, TOWNSHIP 33 SOUTH, RANGE 15 WEST, W.M., AND A PORTION OF SECTIONS 32 AND 33, TOWNSHIP 32 SOUTH, RANGE 15 WEST, W.M., CURRY COUNTY, OREGON.

SCALE: 1" = 400' DATE: DECEMBER 29, 1977

FOR: CITY OF PORT ORFORD
P.O. BOX 318
PORT ORFORD, OREGON 97465

THE POINT OF DIVERSION IS MARKED BY A 1/2" IRON PIPE LOCATED N 9° 32' 36" W A DISTANCE OF 2604.89 FEET FROM THE CENTER QUARTER CORNER OF SECTION 5, TOWNSHIP 33 SOUTH, RANGE 15 WEST, W.M., CURRY COUNTY, OREGON.

LEGEND:

- FOUND BRASS CAP QUARTER CORNER
- SET 1/2" IRON PIPE
- CITY LIMITS
- WATER LINES (4" DIAMETER AND LARGER)

Application No. 55747
Permit No. 42503