


T.2S., R.45E., W.M.

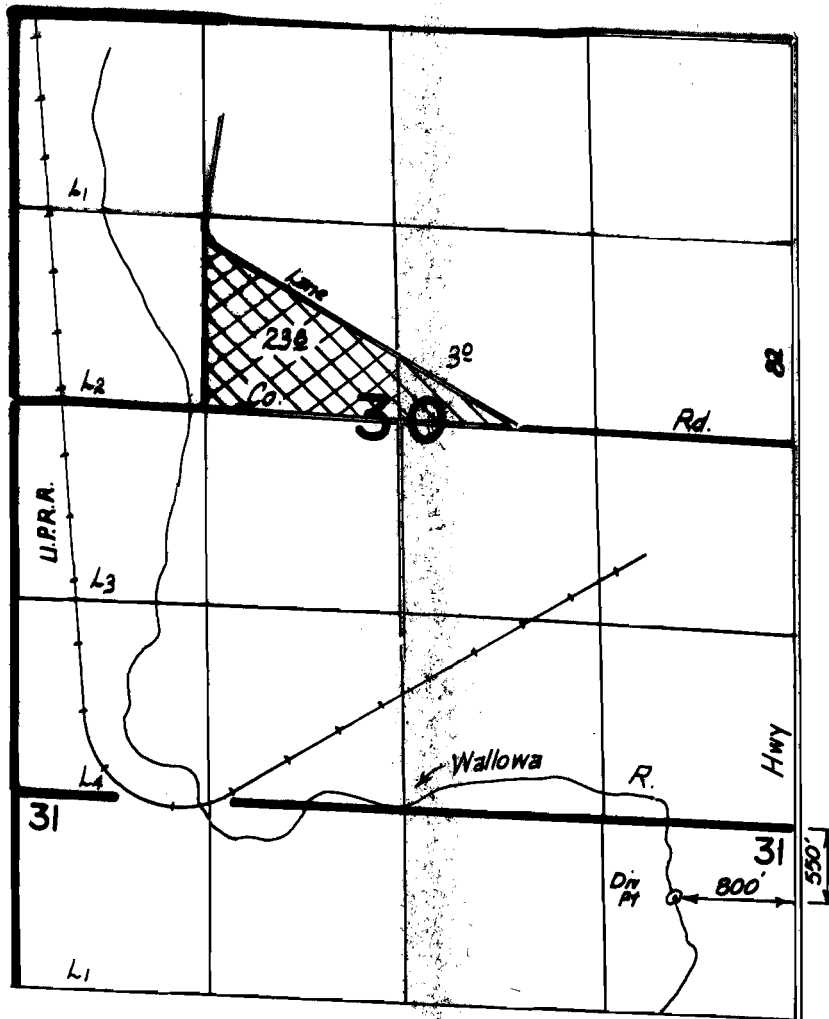


FINAL PROOF SURVEY UNDER



Application No. 55791 Permit No. 41774
IN NAME OF

FRED W. KAUP

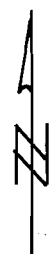Surveyed 8-9 1988 by Vern. Church



Scale: 1" = 1320'

-  Primary Irrigation
-  Supplemental Irrigation