


T. 32 S., R. 15 W., W.M.

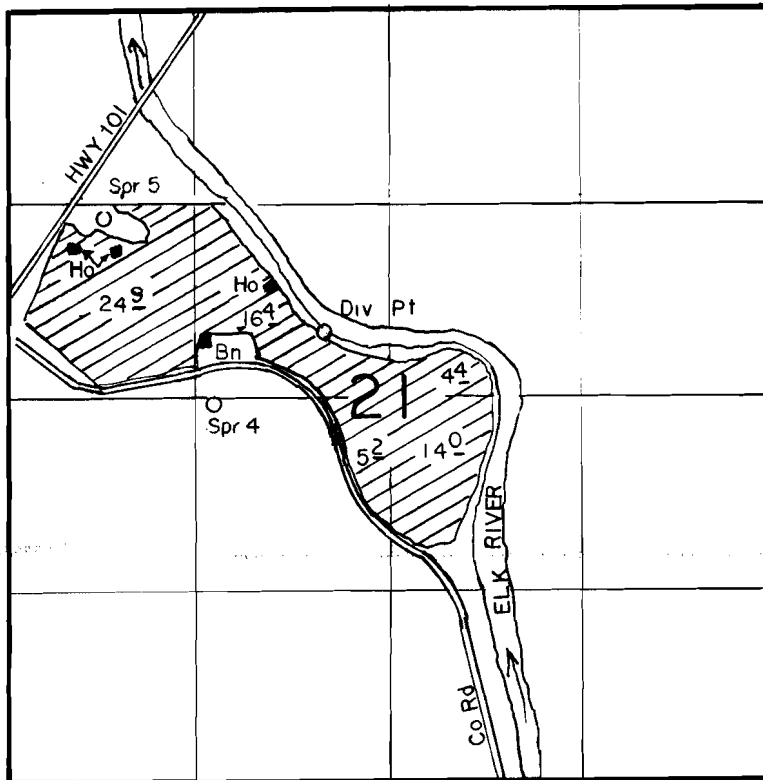

Div Pt Loc 450'N & 2280'E, Spr 4 Loc 50'S & 1400'E, Spr 5 Loc 1230' N & 650'E, All From The W1/4 Of Section 21

SCALE: 1" = 1320'

FINAL PROOF SURVEY
UNDER

Application No. 55884..... Permit No. 41917.....
IN NAME OF

HUNTER PAIGE & JACQUELINE K. BUETTNER

Surveyed JUNE. 25. 1988., by B.S. JAMES.....