


T.38 S., R.14 W., W.M.

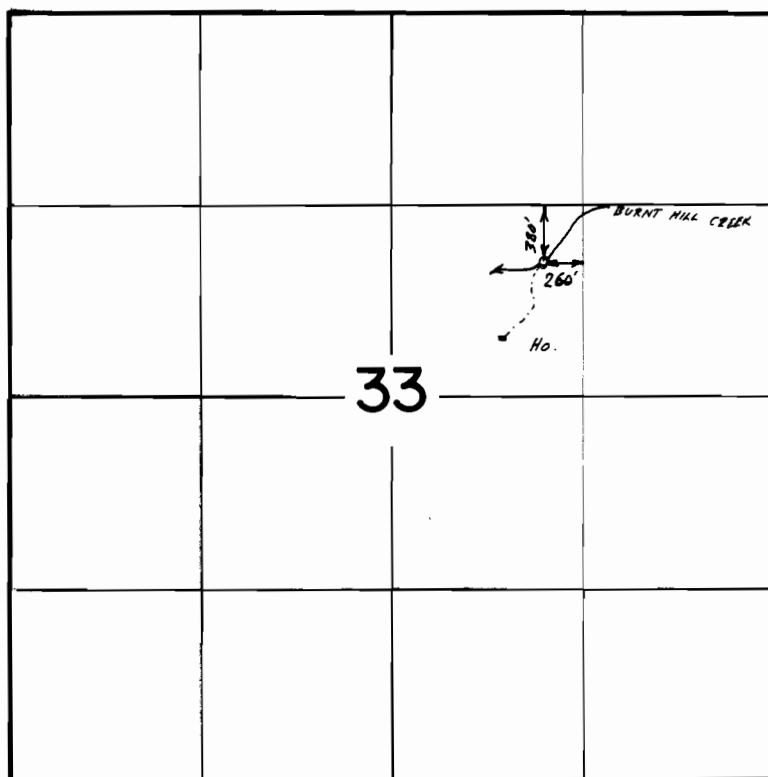

Scale 1"=1320'



FINAL PROOF SURVEY
UNDER

Application No. 56009 Permit No. 41942
IN NAME OF

MARILYN JESTER

Surveyed Oct. 11, 1988, by B.S. JAMES