


T.38S., R.14W., W.M.

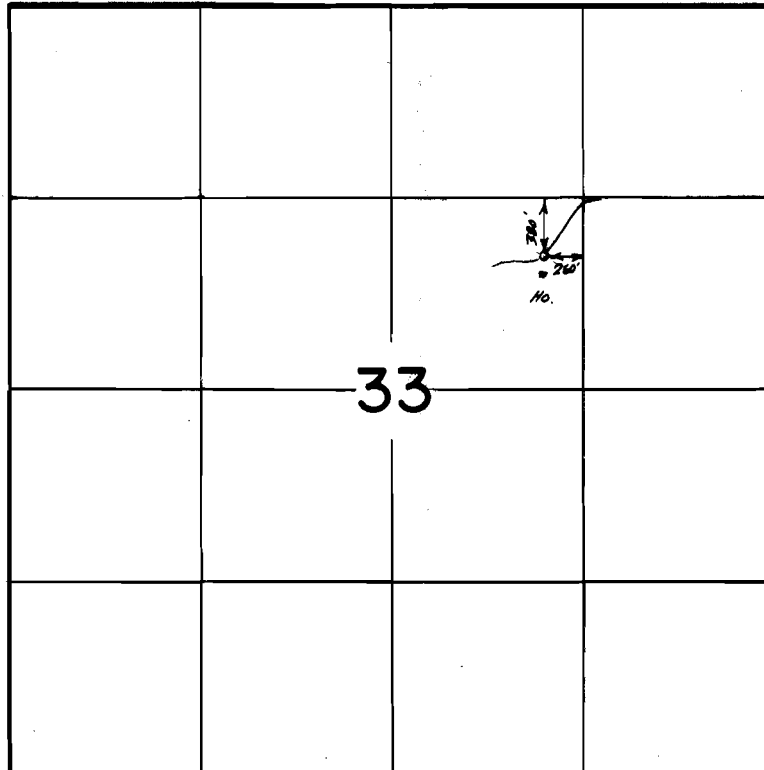

Scale: 1320'

FINAL PROOF SURVEY
UNDER

Application No. 57025. Permit No. 43264, ...
IN NAME OF

.....**MARILYN**.....**JESTER**.....

Surveyed Oct. 11, 1988, by B.S. JAMES