


T.6S., R.41E., W.M.

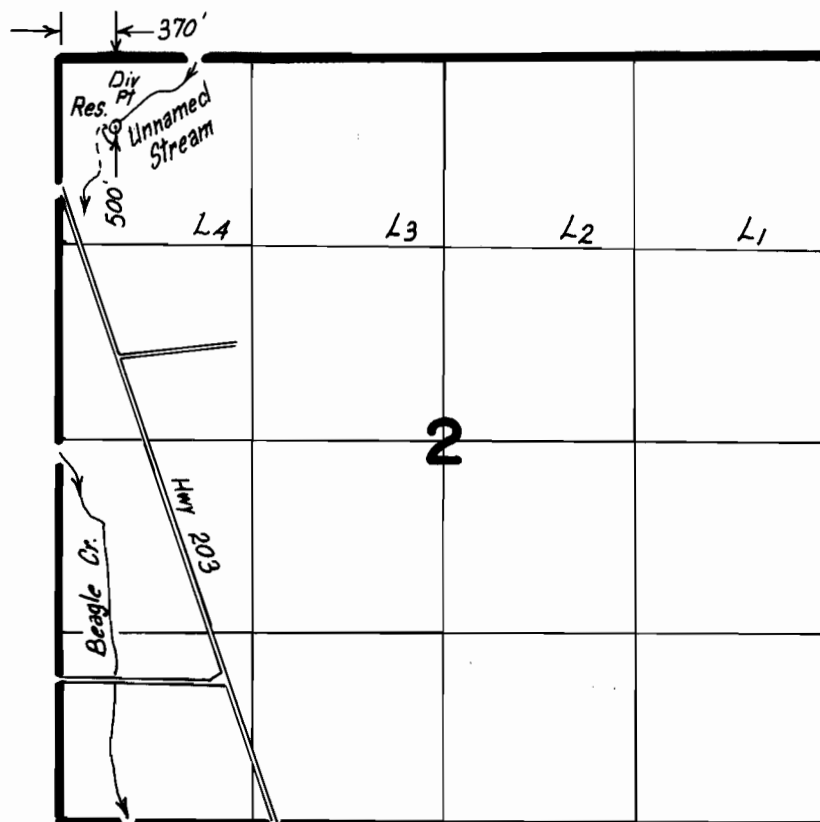

FINAL PROOF SURVEY UNDER

Scale: 1" = 1320'

Application No. R56310 Permit No. R6635
IN NAME OF

THEODORE C. BROWN

Surveyed 4-27 1988, by Vern Church