


T.28S., R.12 W., W.M.

SECTION 15

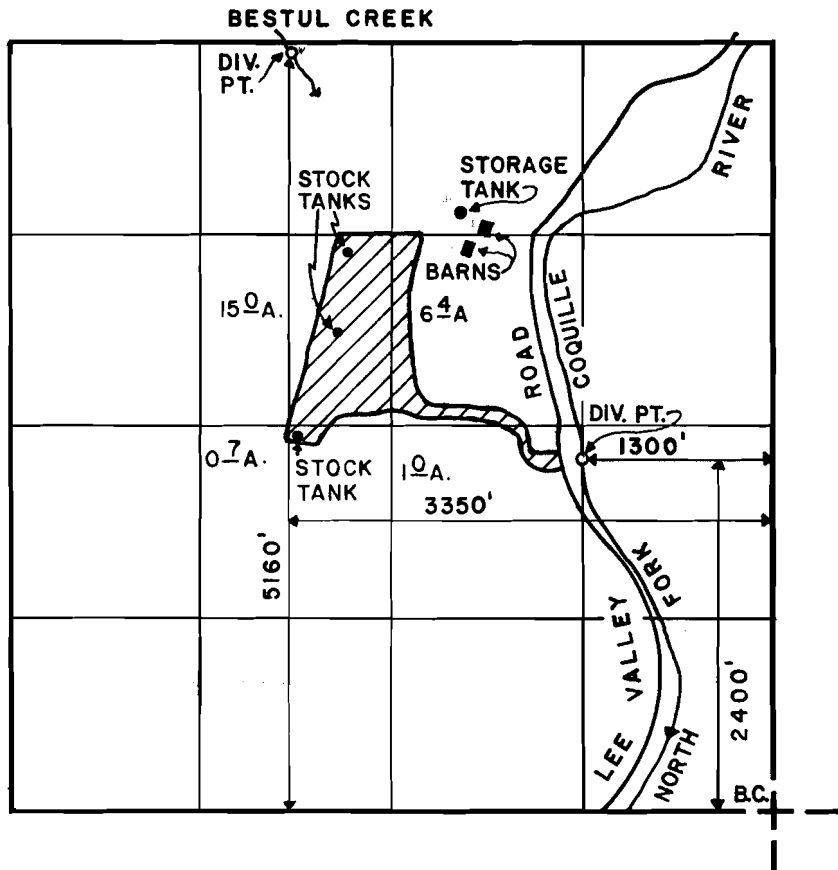

SCALE: 4" = 1 MILE

FINAL PROOF SURVEY UNDER

Application No. 56479 54889 Permit No. 42455 41166

IN NAME OF

ROSS, ROBERT

Surveyed AUG. 27, 1985, by J.M. SCHMORDE