


T. 40 S., R. 14 W., W.M.

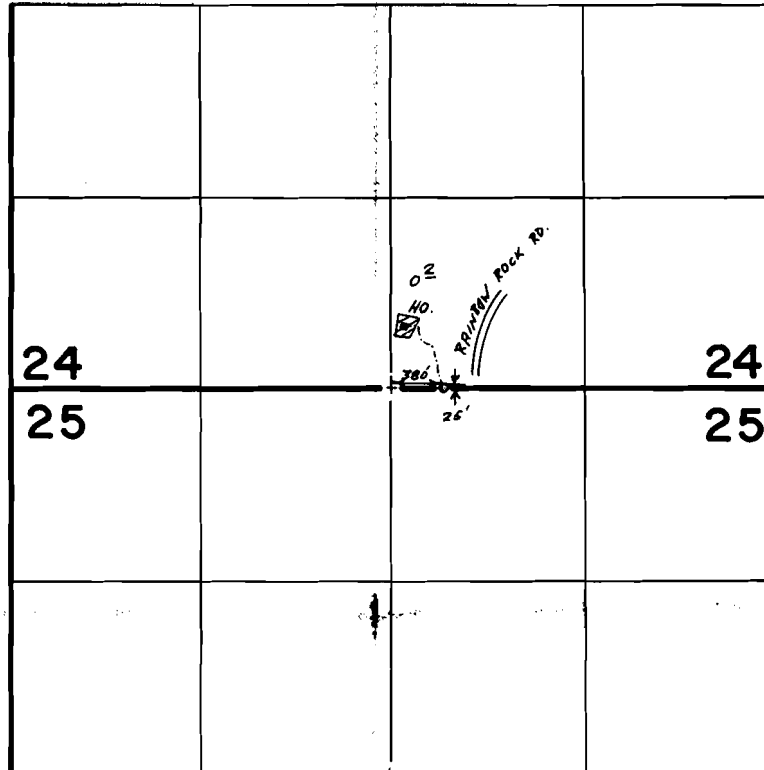

FINAL PROOF SURVEY
UNDER

Application No. 56871... Permit No. 43835....
IN NAME OF

JIM C. & JOSELLA E. TOMPKINS

Surveyed Oct. 12... 1988, by B.S. JAMES.....