



T.2S., R.45E., W.M. & T.3S., R.45E., W.M.

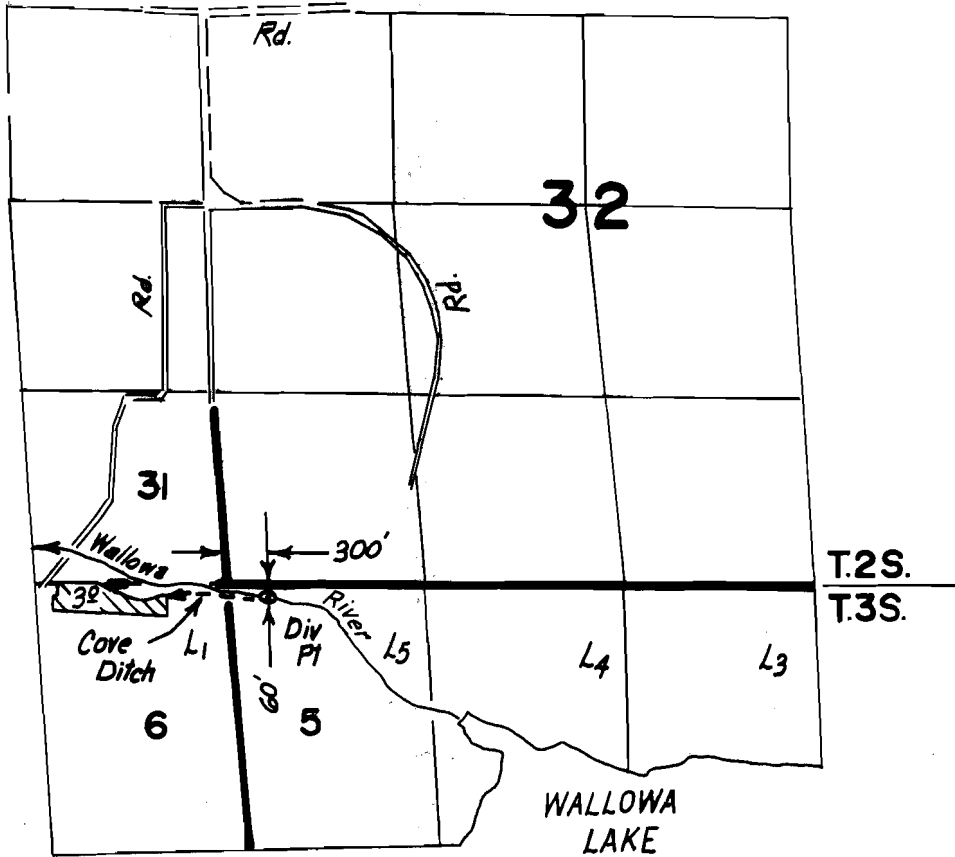

FINAL PROOF SURVEY UNDER

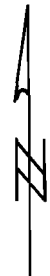

Scale: 1" = 1320'

Application No. **57001** Permit No. **42858**
IN NAME OF

RICHARD O. KANGAS

Surveyed **8-15** 19**88**, by **Vern Church**