


T.1S., R.38E., W.M.

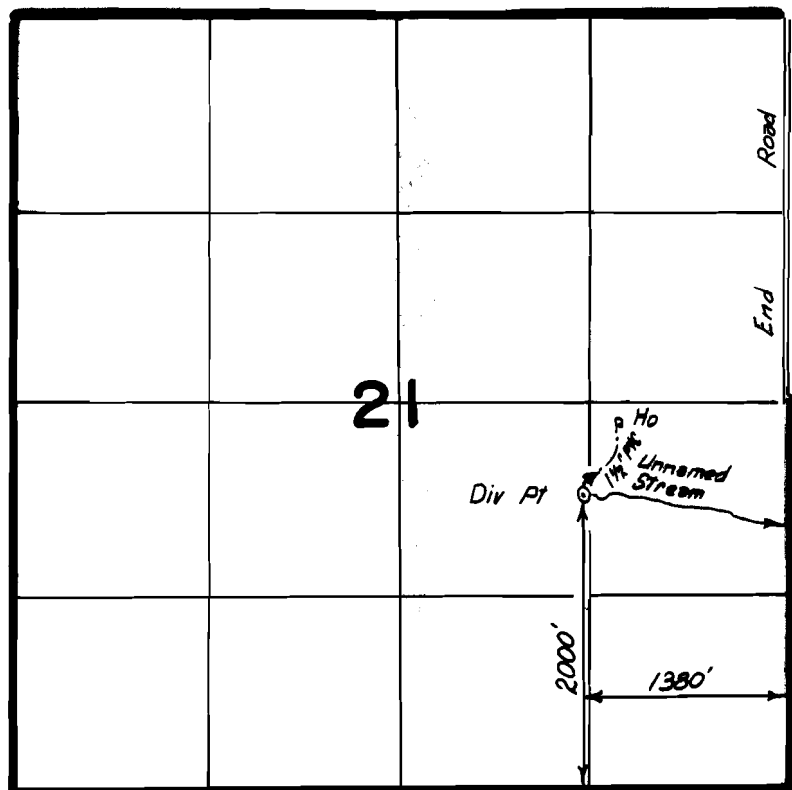

FINAL PROOF SURVEY
UNDER

Scale: 1" = 1320'

Application No. 57126 Permit No. 42933
IN NAME OF

DANIEL LEE CLEMENS

Surveyed 6-1-1988, by Vern Church