
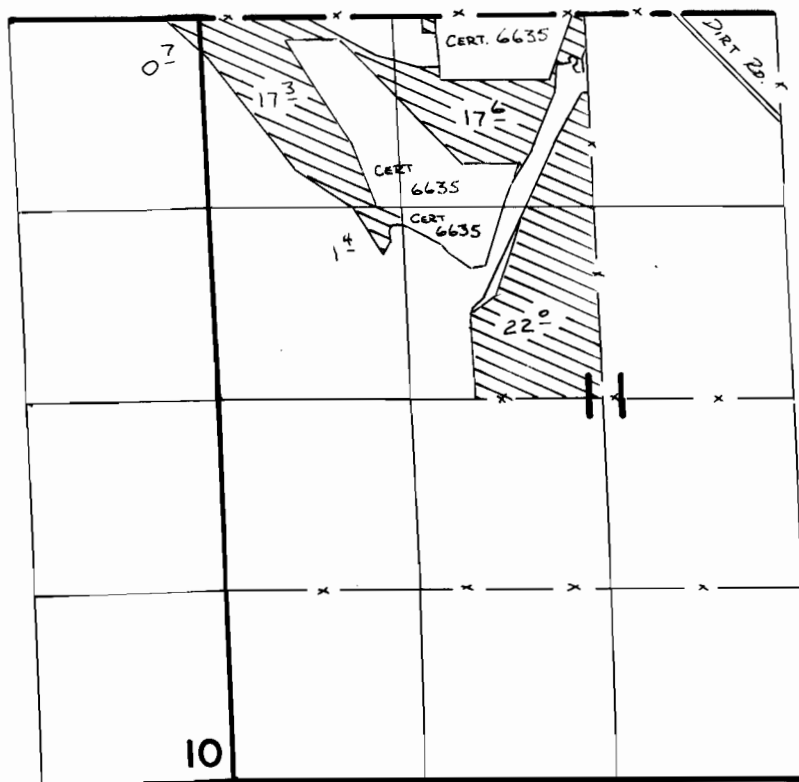


T. 4S., R. 41E., W.M.

6

T. 4S., R. 40E., W.M.

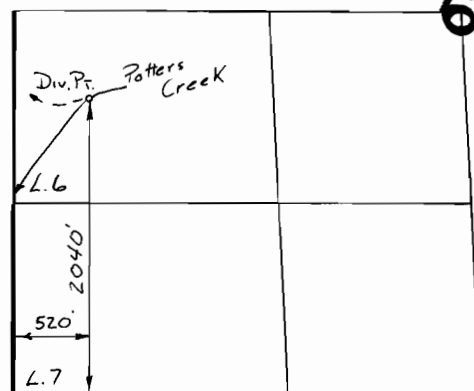

SCALE 1" = 1320'

FINAL PROOF SURVEY UNDER

Application No. **57383** Permit No. **43180**
IN NAME OF

ROBERT L. & NELLIE A. MUDD

Surveyed 9-6 1988, by V. H. Church