


T. 31 S., R. 1 W., W.M.

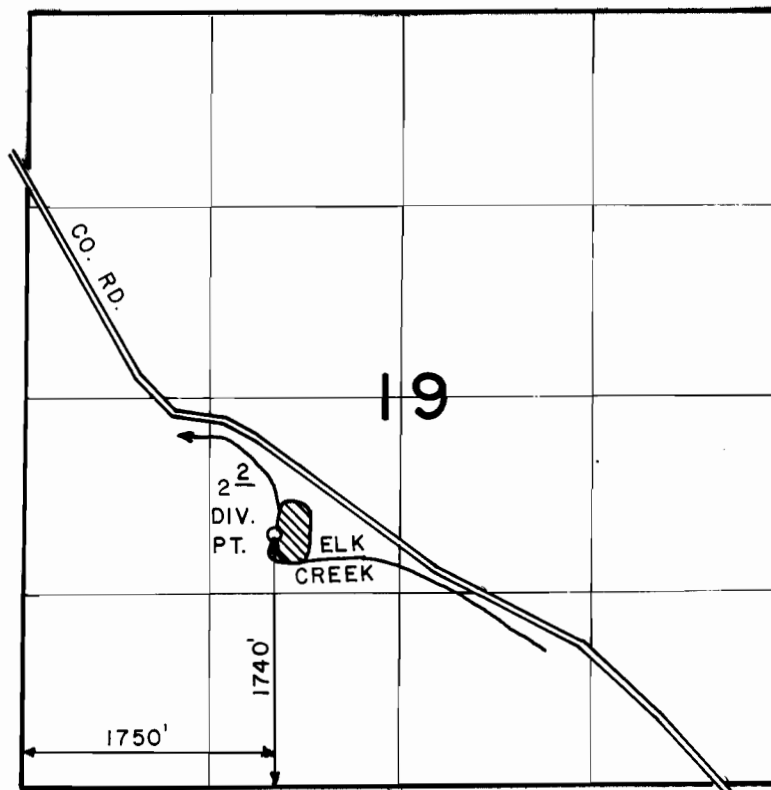

SCALE: 4" = 1 MILE

FINAL PROOF SURVEY
UNDER

Application No. 57421... Permit No. 43356...
IN NAME OF

RICHARD L. BONNEY

Surveyed APRIL 5, 1988, by J.M. SCHMORDE.