


# T. 35 S., R. 14 W., W. M.

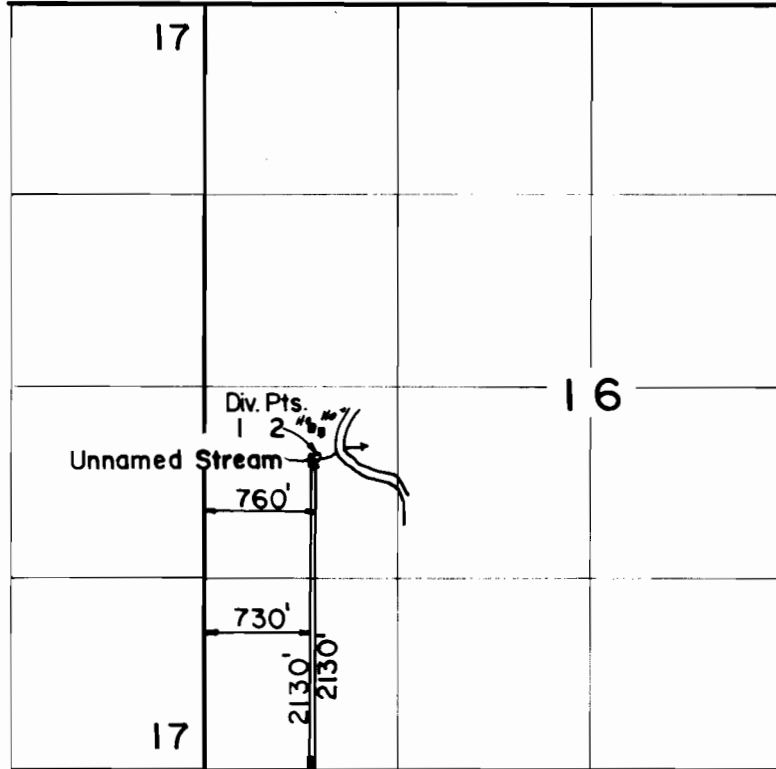

Scale: 1" = 1320'

## FINAL PROOF SURVEY UNDER

Application No. 58564. Permit No. 44250...  
IN NAME OF

.....NANCY A. JOKELA.....

Surveyed JUN. 29. 19.88, by B. S. JAMES