


T. 40 S., R. 14 W., W. M.

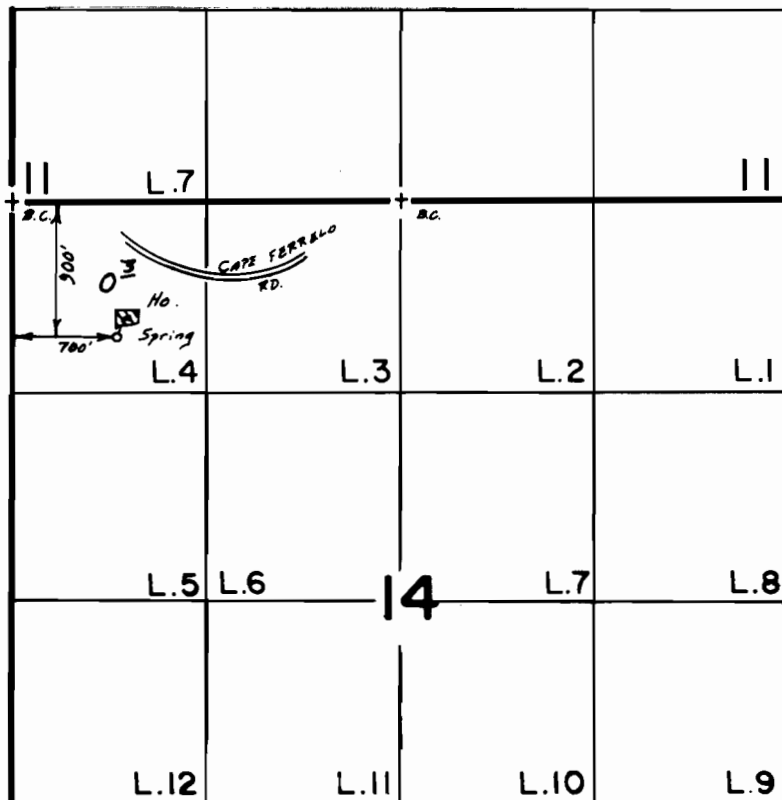

Scale 1" = 1320'

FINAL PROOF SURVEY
UNDER

Application No. 59211... Permit No. 44537...
IN NAME OF

DAVID & LEA-ANN RUSSELL

Surveyed Sept. 30, 1987, by B.S. JAMES.....