



Scale: 1"=1320'
T. 7S., R. 41E., W.M.

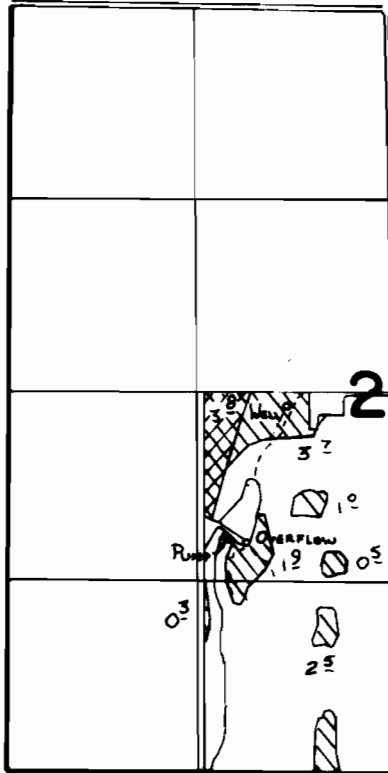


Scale: 1"=1/2 mile
T. 5S., R. 42E., W.M.

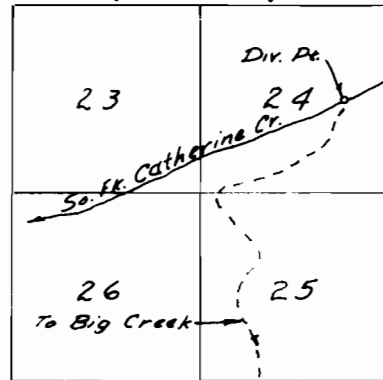

SEWE

Scale: 1"=1/2 mile
T. 6S., R. 42E., W.M.

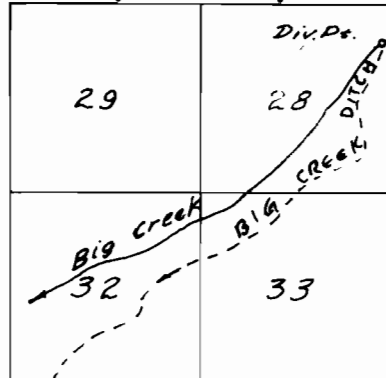

SEWE



Per. 45437



Per. 45440

FINAL PROOF SURVEY

UNDER

Application No. **61032** Permit No. **45440**
60436 Permit No. **45437**
 IN NAME OF

.....**JOHN R. & DIANE G. BGAN**.....

Surveyed ...**5-21**... 19**84**., by **V.L. Church**.....