




Scale: 1" = 1320'  
T.7S., R.41E., W.M.

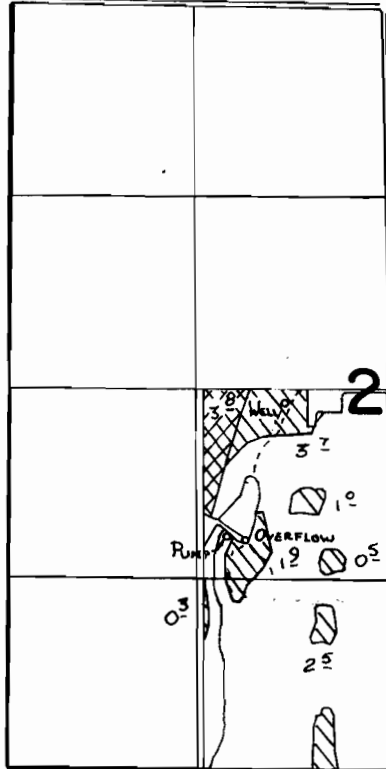

Scale: 1" = 1 mile  
T.5S., R.42E., W.M.

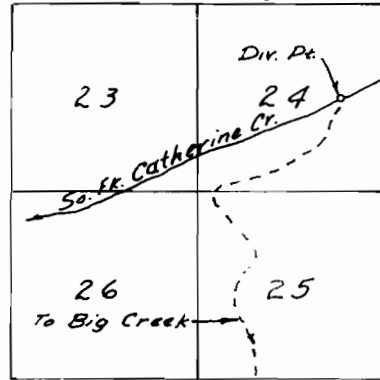

Scale: 1" = 1 mile  
T.6S., R.42E., W.M.

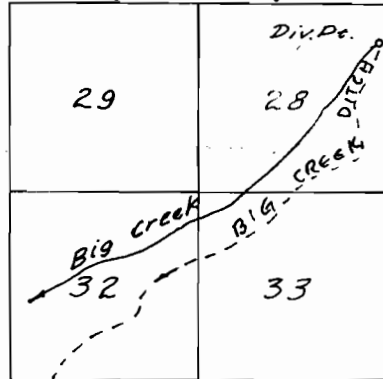

Per. 45437



Per. 45440

# FINAL PROOF SURVEY

UNDER

Application No. 61032 60436 Permit No. 45440 45437

IN NAME OF

JOHN R. & DIANE G. BEAN

Surveyed ... 5-21 ... 1984, by V.L. Church