


# T. 38 S., R. 3 E., W.M.

## SECTION 22

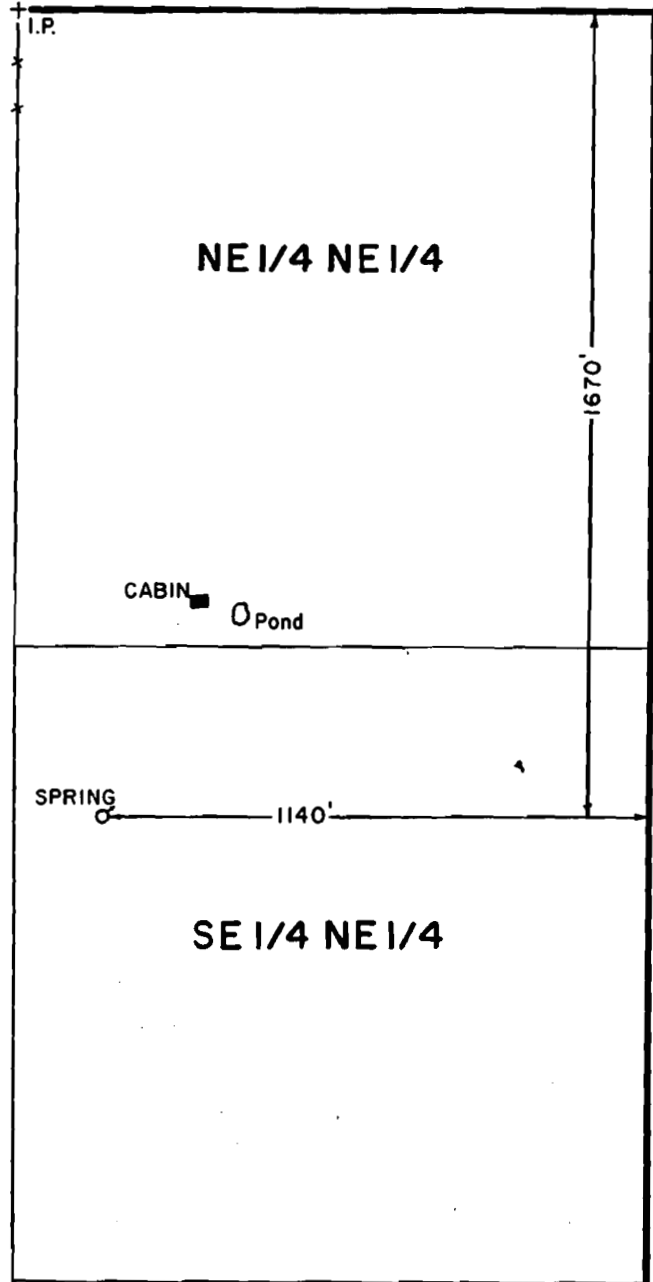

SCALE: 1" = 400'

### FINAL PROOF SURVEY UNDER

Application No. 63045 Permit No. 46650  
IN NAME OF

LEE MERRIMAN

Surveyed SEPT. 6. 1989, by B. S. JAMES