


T.34S., R.6W.,WM.

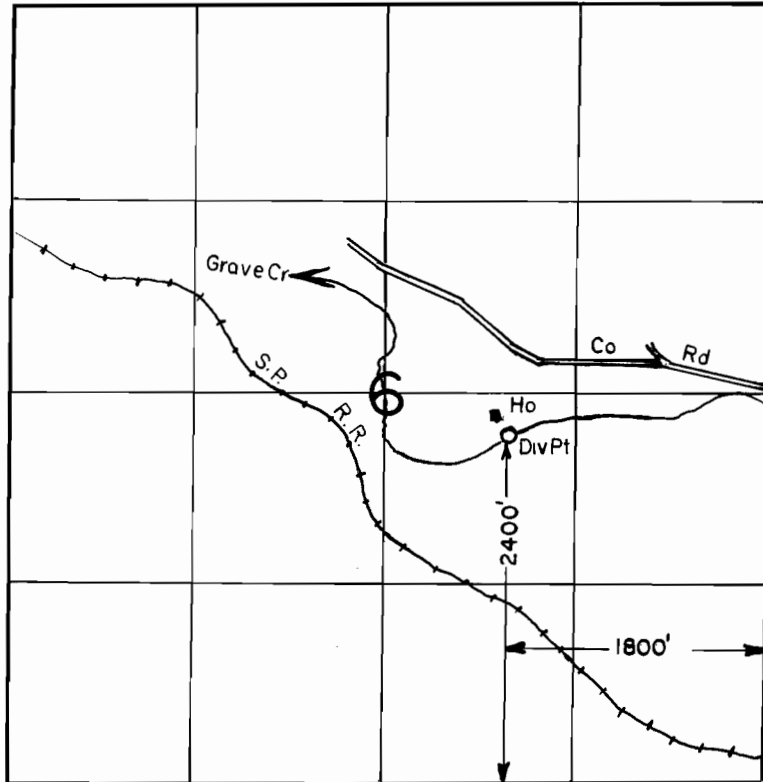

SCALE: 1"=1320'

FINAL PROOF SURVEY
UNDER

Application No. 63390... Permit No. 47124.....
IN NAME OF

JAMES C. CARTER

Surveyed MAY...2... 19.89., by B.S. JAMES.....