


T. 9S., R. 21E., W.M.

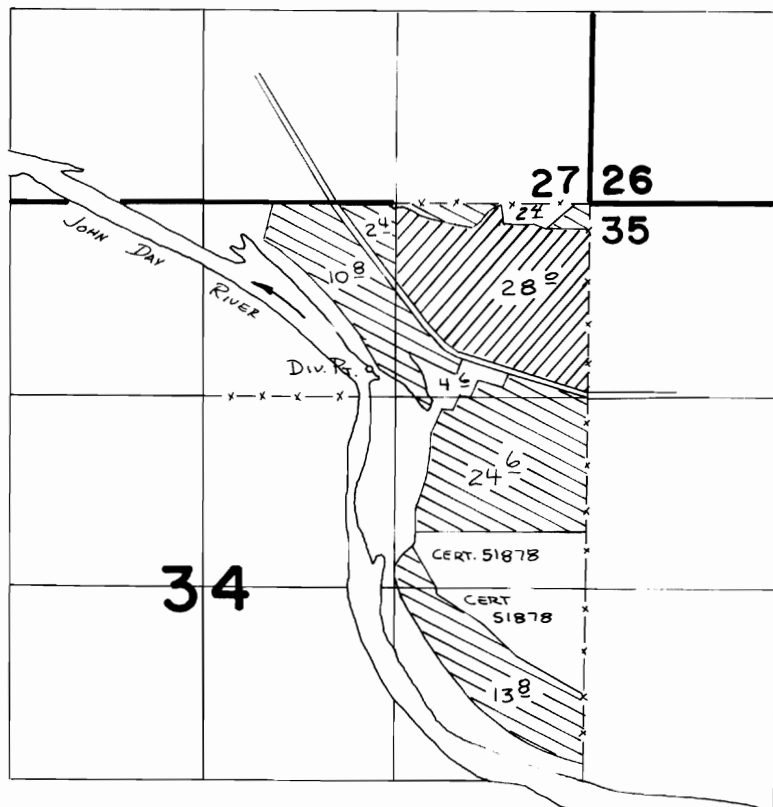

SCALE: 1"=132'

DIV. PT. LOCATION: 1140'S. & 1500'W. FROM NE COR.
SECTION 34

FINAL PROOF SURVEY UNDER

TRANSFER 5231

Application No. **64976** Permit No. **47603**

IN NAME OF

EDWARD P. & ANNE CHARAPATA

Surveyed 4-21 1986, by V.L. Church