


RECEIVED

SEP 22 1983
WATER RESOURCES DEPT.
SALEM, OREGON

T 9 S R 38 E WM

Section 12

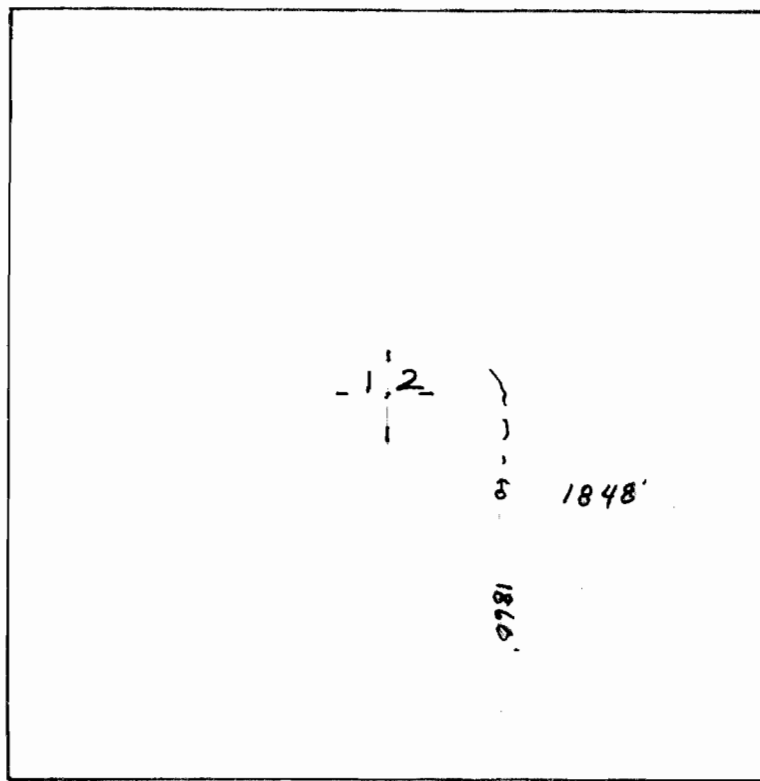

Marble Springs


NW 1/4 SE 1/4

Application No. 66616
Permit No. 49777

RECEIVED
 SEP 22 1983
 WATER RESOURCES DEPT.
 SALEM, OREGON

49777
 66616

Application No.
 Permit No.

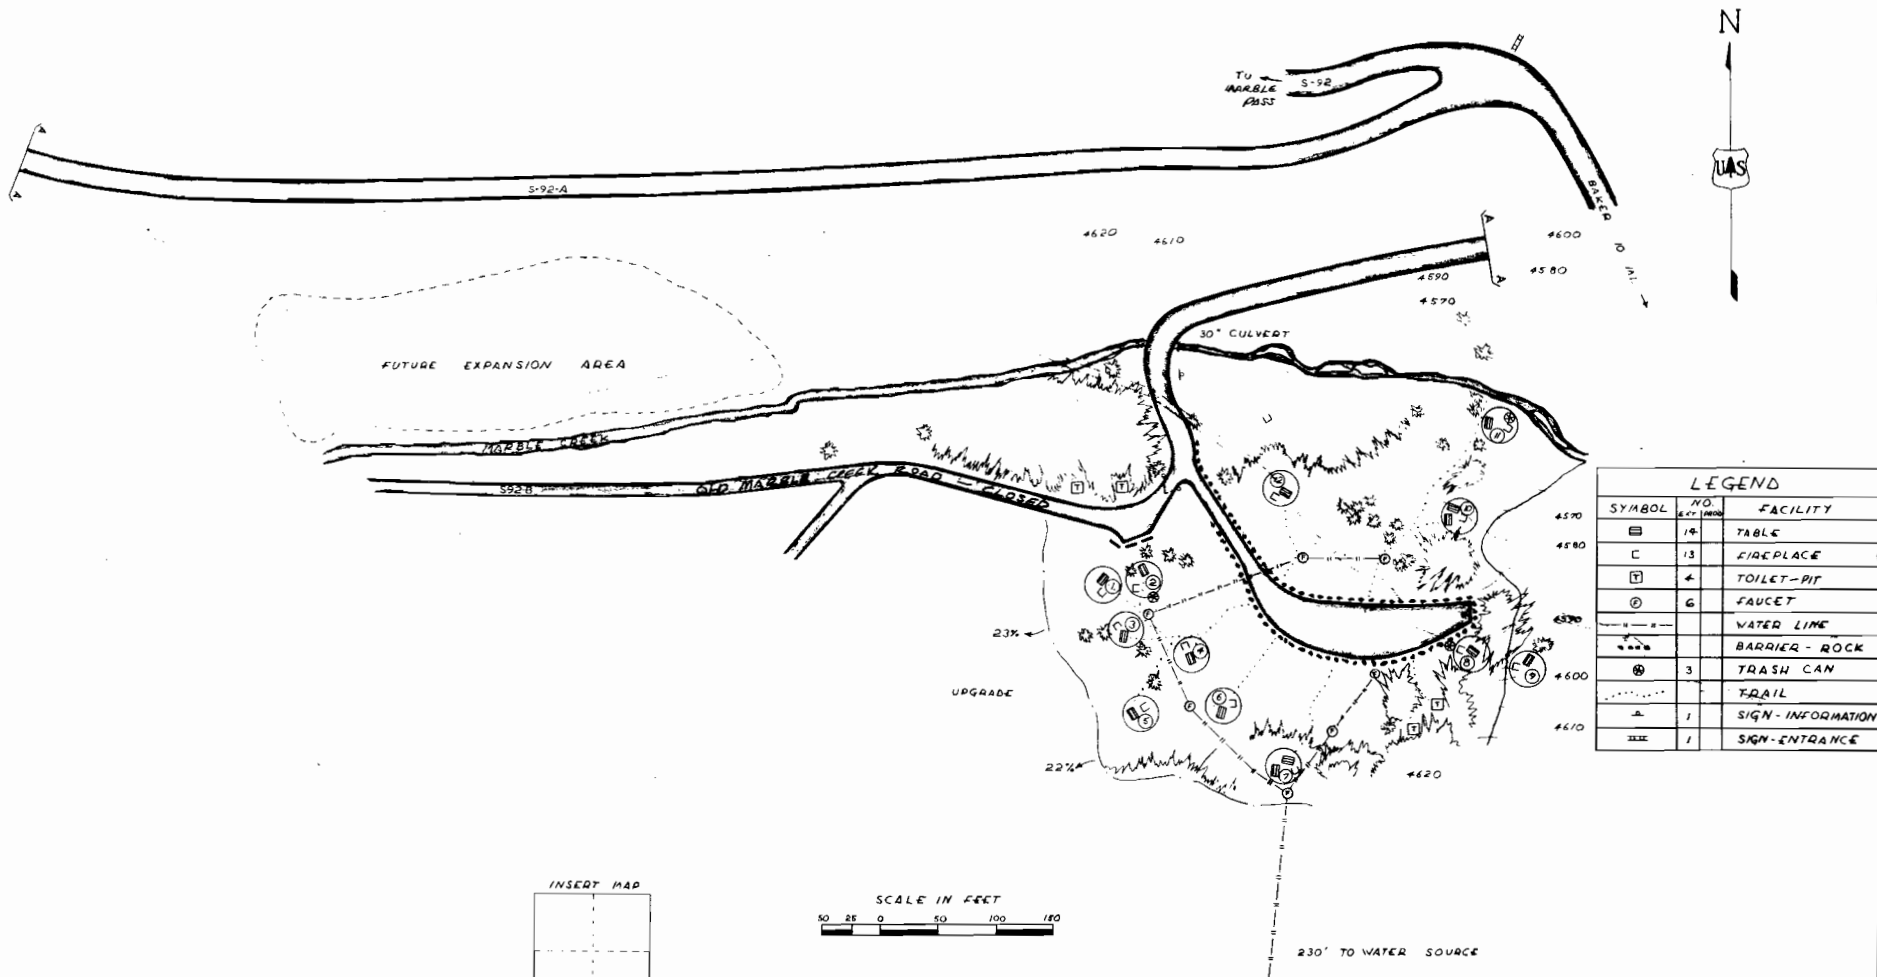

LEGEND		
SYMBOL	NO.	FACILITY
[Symbol]	14	TABLE
[Symbol]	13	FIREPLACE
[Symbol]	4	TOILET-PIT
[Symbol]	6	FAUCET
[Symbol]		WATER LINE
[Symbol]		BARRIER - ROCK
[Symbol]	3	TRASH CAN
[Symbol]		TRAIL
[Symbol]	1	SIGN - INFORMATION
[Symbol]	1	SIGN - ENTRANCE

INSERT MAP
 SEC 1/4 SEC. 12, T. 9S, R. 38E, W. 1

SCALE IN FEET
 50 25 0 50 100 150

DESIGNED BY: V. T. WILSON
 DRAWN BY: V. T. WILSON
 APPROVED: [Signature]
 DATE: 5-20-77
 DATE: 6/9/77

U.S. DEPARTMENT OF AGRICULTURE
 FOREST SERVICE
 WALLAWA-WHITMAN National Forest
 THE PACIFIC NORTHWEST REGION

MARBLE CREEK
 PICNIC GROUND
 BAKER RANGER DISTRICT
 WFER# 6-0
 COOR 78.1
 UPDATED - 9-78 - WAW