


T. 26 S., R. 6 & 7 W., W.M.

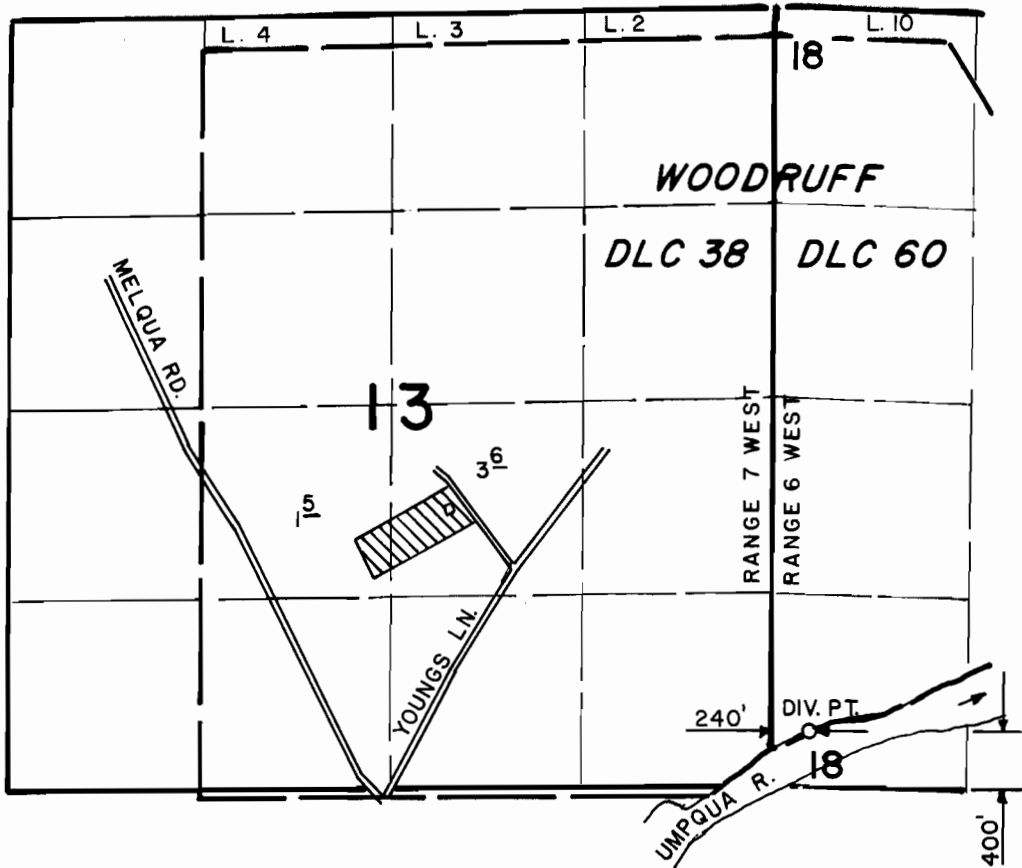

SCALE: 4" = 1 MILE

FINAL PROOF SURVEY UNDER

Application No. 68399... Permit No. 49395.....
IN NAME OF

..... WENDY ESTABROOK

Surveyed MAY 17.... 1988., by J. M. SCHMORDE