


T. 1 S., R. 4 E., W.M.

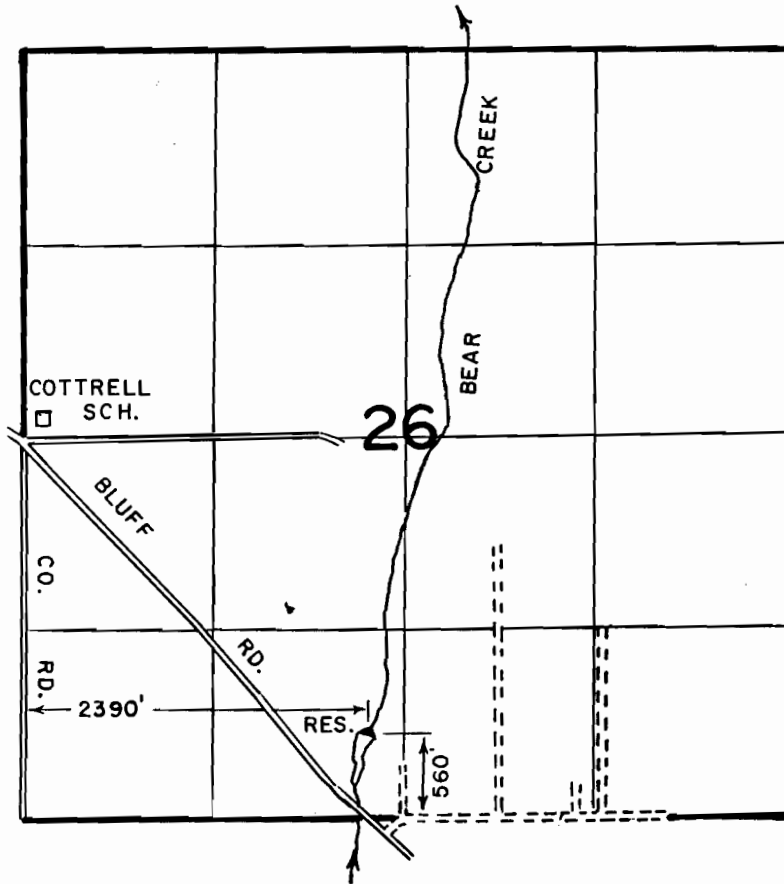

**FINAL PROOF SURVEY**  
UNDER

68963                      49931  
Application No. R-68826    Permit No. R-10820  
IN NAME OF

**KERRY D. BREDEKAMP**

Surveyed MAY 1 1990, by T.M. WARREN

5-16-90 DSM  
P.T.S.  
DFK-ILL-243