


T. 1 S., R. 4 E., W. M.

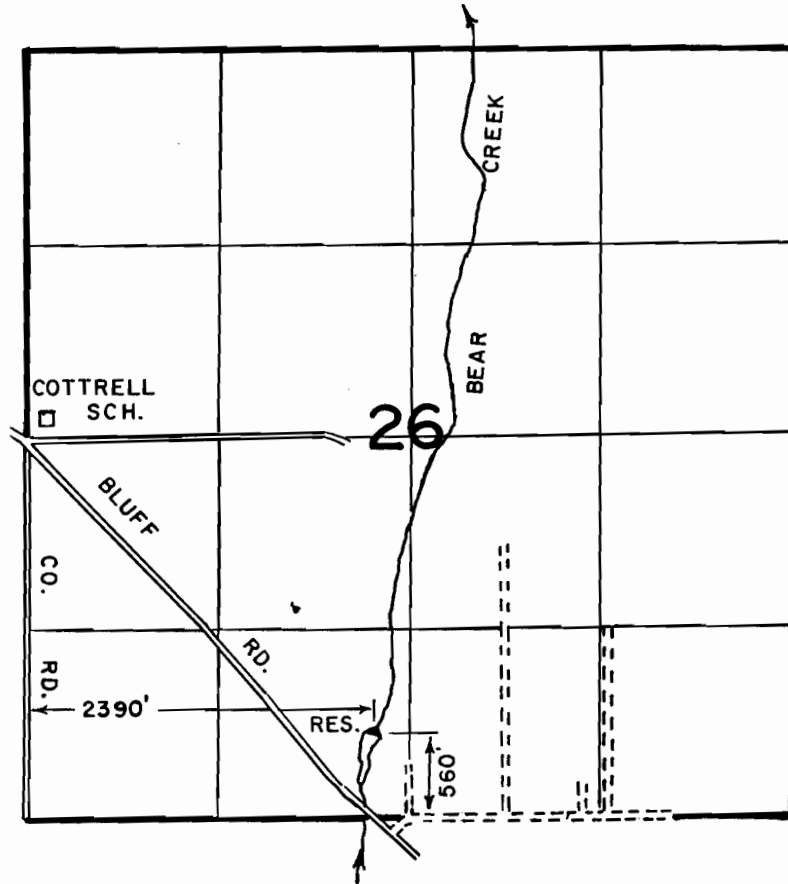

**FINAL PROOF SURVEY**  
**UNDER**

68963                      49931  
Application No. R-68826    Permit No. R-10820...  
**IN NAME OF**

**KERRY D. BREDEKAMP**

Surveyed **MAY 1** 19**90**, by **T.M. WARREN**

5-16-90 DSM  
P.T.S.  
DFK-ILL-243