


T. 37 & 38 S., R. 11 & 11 1/2 E., W.M.

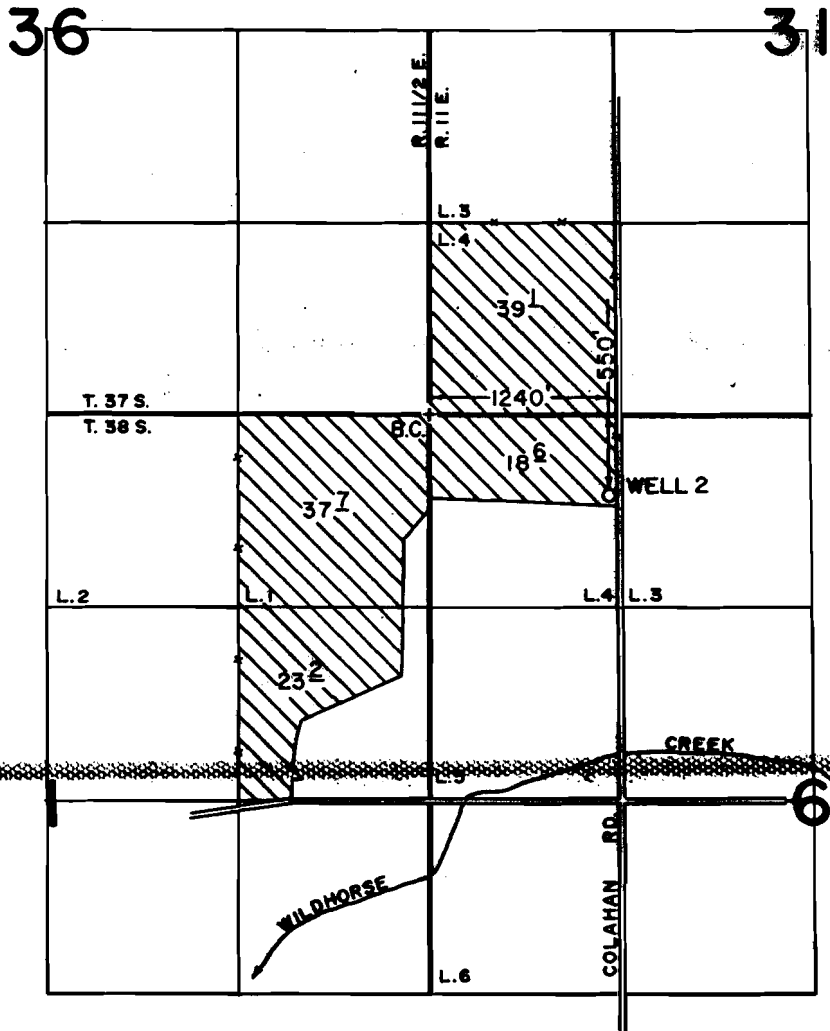

Back Col. Colahan Valley Wells

SCALE: 1" = 1320'

FINAL PROOF SURVEY
UNDER

Application No. G-6235 Permit No. G-5330.....
IN NAME OF

COLAHAN PROPERTY ARRANGEMENT

Surveyed SEPT. 26 1989., by B. W. BISHOP.....