


T. 10S., R. 4W., W.M.

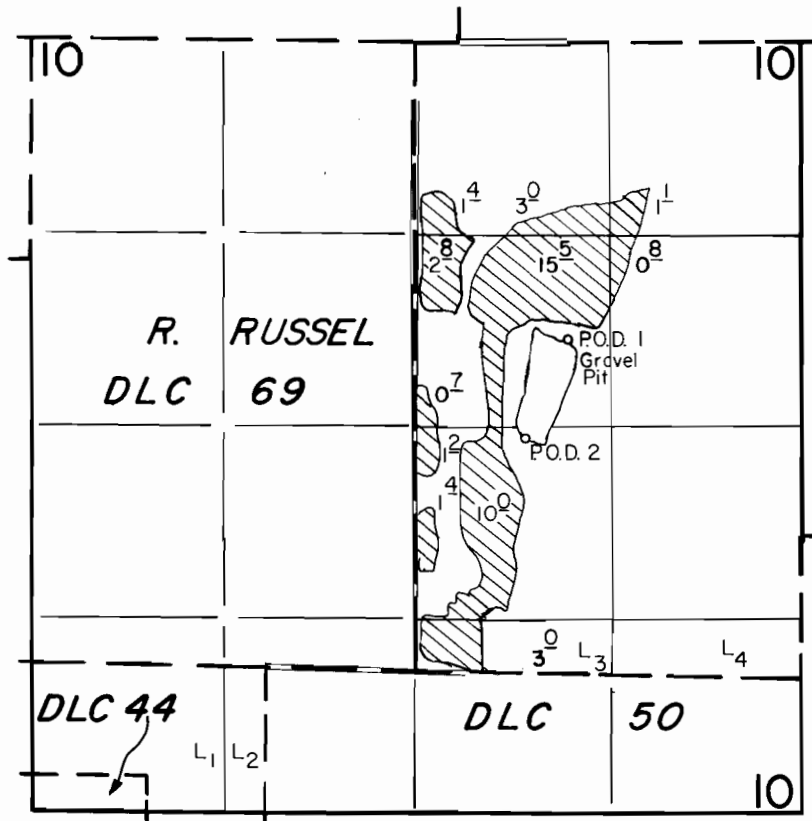

P.O.D. 1 Loc.: 2250' N. & 1050' E.
 P.O.D. 2 Loc.: 1580' N. & 760' E., both from SE Cor. DLC 69.

Scale: 1" = 1320'

FINAL PROOF SURVEY UNDER

Application No. G-7865. Permit No. G-7288.....
 IN NAME OF

JEANNE VANDERPOOL

Surveyed April 21, 1987, by T. Warren.....