
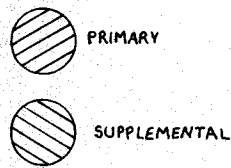


67820
65237

T. 6 N. R. 33 & 34 E. W.M.

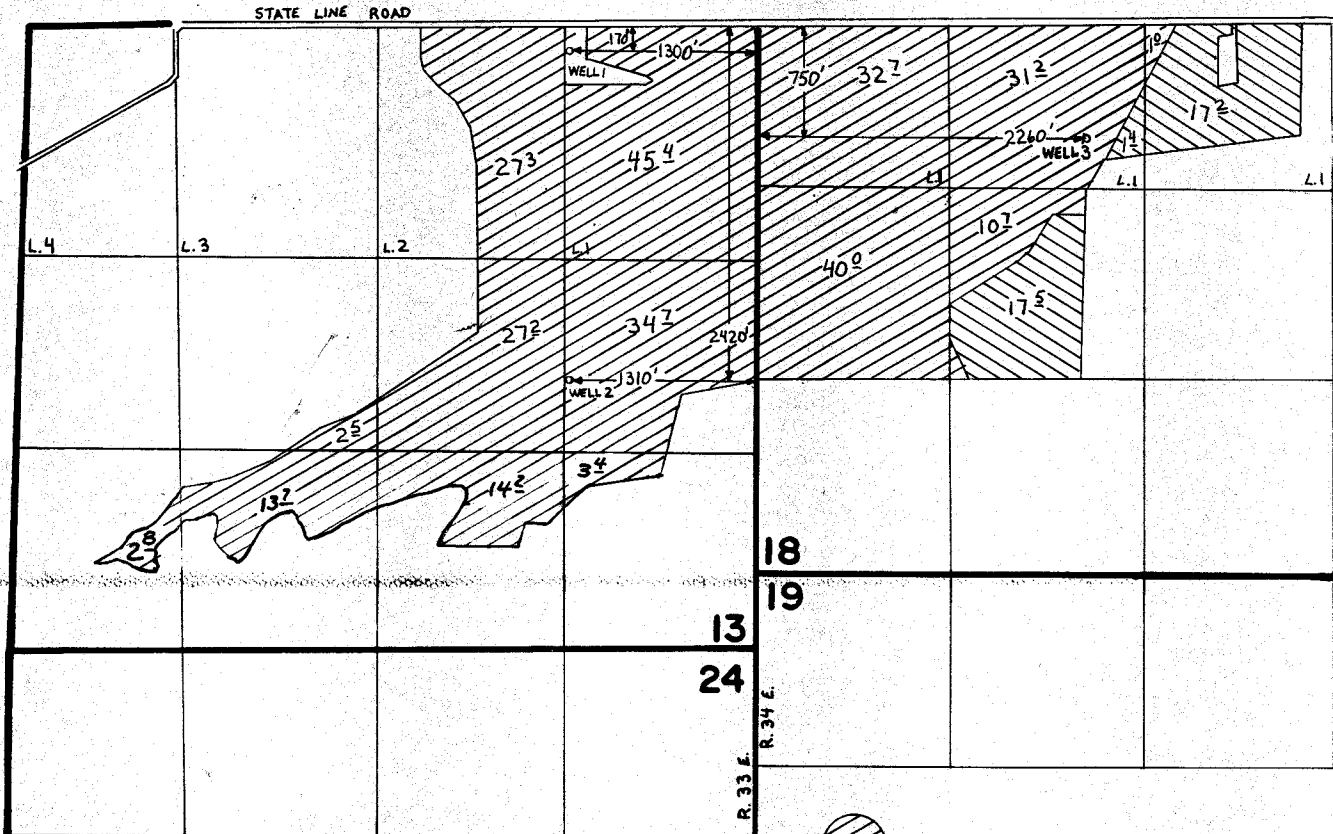


FINAL PROOF SURVEY UNDER

Application No. G.8422 Permit No. G.7826.....
IN NAME OF

BURLINGAME...LAND & LIVESTOCK, INC.

Surveyed March 2.. 1987., by ..V.Church.....

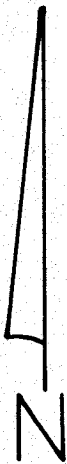

Scale 1" = 1320'