


T. 35 S., R. 2 W., W.M.

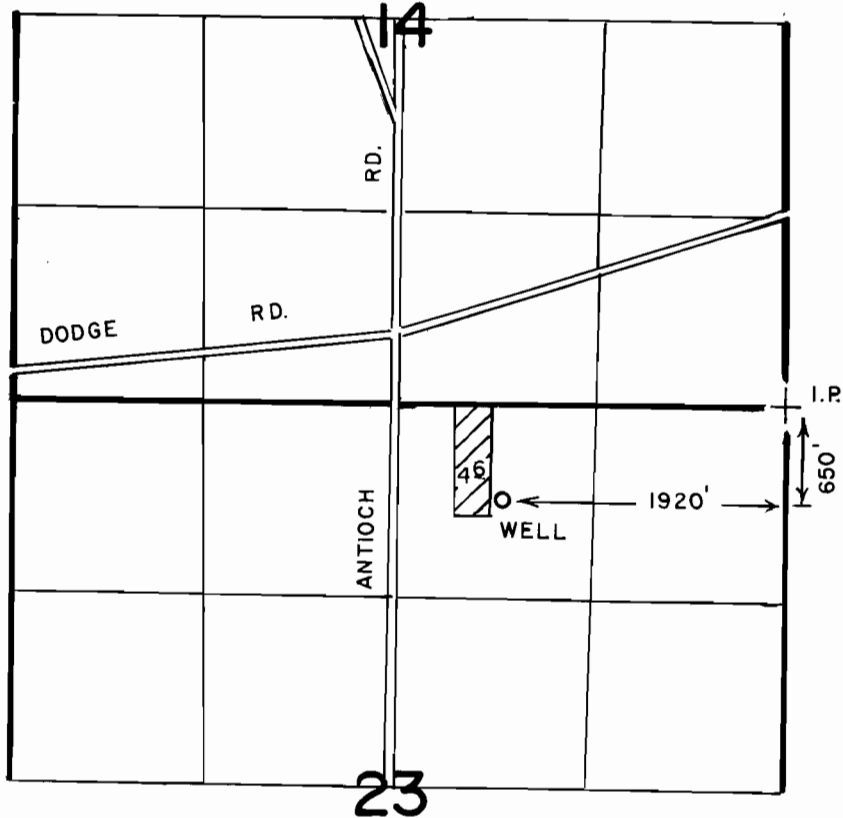

FINAL PROOF SURVEY
UNDER

Application No. G-10949 Permit No. G-10112.....

IN NAME OF

ERNEST A. & MARY E. CAMPBELL

Surveyed MARCH 29 1990, by B. S. JAMES